


CERTIFIED RECORD OF LAND CORNER MONUMENTATION

North quarter corner to Section 3, T1S, R32E, W M.

Index: 1S 32 A-15

History of original corner establishment:  
Corner originally set by Thompson in contract 106 dated 1864. His record reads: 40.00 Set post for 1/4 sec. corner in mound of earth with charred stake, pits, trench & c as per instructions.

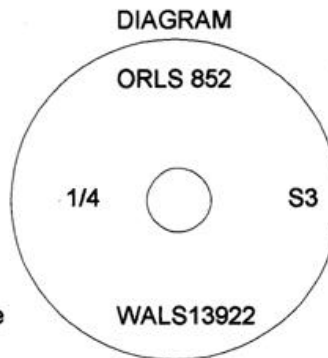

Evidence Found: Projected lines of an east - west fence line and a south fence line intersect on the east shoulder of Highway 395. The point is 22.053 chains east of the found stone at the southwest corner of Section 34, T1N, R32E. Record 22.00 chains. The point is 58.41 chains west of the found stone at the southeast corner of Section 34, T1N, R32E. Record - 58.00 chains

Description of monument and accessories I established to perpetuate the original location of this corner:  
At the point of the projected fence intersection, I set a 1 1/8" x 36" drill steel with a 1 1/4" brass washer attached. The brass washer is stamped ORLS 852 1/4 S3 WALS 13922. The drill steel is set 1" below the surface of the existing asphalt pavement.

I set four 5/8" by 24" rebars with 1.25" red plastic caps stamped ORLS 852 and WALS 13922 as described below:

- a rebar bears S89°28'E, 68.37 feet at the foot of a railroad tie;
- a rebar bears N01°41'E, 96.92 feet at north corner of highway access road;
- a rebar bears S01°49'W, 123.68 feet at intersection of west highway right of way fence and west bound fence;
- a rebar bears N89°45'W, 225.10 feet at foot of railroad tie;

The bearings are true.

This work was done May 13, 1997, and witnessed by Stephen K. Haddock.

Office of \_\_\_\_\_, I hereby certify that the within instrument was filed  
State of \_\_\_\_\_  
in this office for record on the \_\_\_\_\_ day of \_\_\_\_\_ by \_\_\_\_\_  
\_\_\_\_\_( COUNTY OFFICIAL ) \_\_\_\_\_ ( DEPUTY )

County of Umatilla



*David L. Haddock*



RECEIVED BY  
Umatilla County Surveyor  
Date 7-97  
Rec'd By KK  
No. 97-140-C