


CERTIFIED RECORD OF LAND CORNER MONUMENTATION

Cornet to Sections 2 and 3, T1S, R32E, W M.

Index: 1S 32 A-17

History of original corner establishment:
Corner originally set by Thompson in contract 106 dated 1864.
His record reads: 80.00 Set post for corner to secs. 2 and 3
in mound of earth with charred stake, pits, trench &c as per
instructions.

DIAGRAM

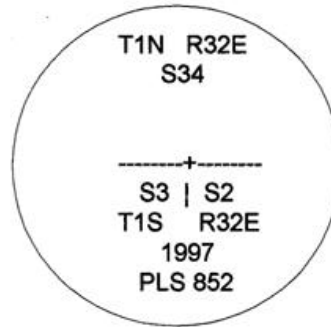

Evidence Found: Found fence intersection 62.044 chains east of found stone at the southwest corner of Section 34, T1N, R32E. Record - 62.00 chains. Point is 18.420 chains west of the found stone at the southeast corner of Section 34, T1N, R32E. Record - 18.00 chains.

Description of monument and accessories I established to perpetuate the original location of this corner:

At the fence intersection, I set a 1.25" x 30" galvanized iron pipe with a 2.25" brass cap stamped as shown in the diagram. The top of the monument is flush with the surface of the ground.

I constructed a collar of stone around the monument.

I set four 5/8" by 24" rebars with 1.25" red plastic caps stamped ORLS 852 and WALS 13922 as described below:

- a rebar bears N89°42'E, 27.33 feet 18" below the surface;
- a rebar bears N00°47'W, 31.84 under a north bound fence;
- a rebar bears S00°53'W, 17.45 feet under a south bound fence;
- a rebar bears S89°14'W, 26.00 feet under a west bound fence;

The bearings are true.

This work was done May 13, 1997, and witnessed by Stephen K. Haddock.

Office of _____, I hereby certify that the within instrument was filed
 State of _____ County of Umatilla
 in this office for record on the _____ day of _ by _____
 _____ (COUNTY OFFICIAL) (DEPUTY)



David L. Haddock



RECEIVED BY
 Umatilla County Surveyor
 Date 7-97
 Rec'd By RR
 No. 97-140-C