


CERTIFIED RECORD OF LAND CORNER MONUMENTATION

North quarter corner to Section 2, T1S, R32E, W M.

Index: 1S 32 A-19

DIAGRAM

History of original corner establishment:
Corner originally set by Thompson in contract 106 dated 1864. His record reads: 40.00 Set post for closing 1/4 sec. corner.

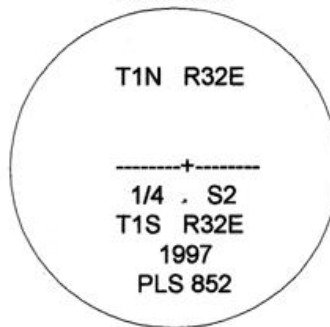

Evidence Found: None

Description of monument and accessories I established to perpetuate the original location of this corner:

At the point proportioned between the corner of Sections 34 and 35, and the south 1/4 corner of Section 35, T1N, R32E,

I set a 1.25" x 12" galvanized iron pipe with a 2.25" brass cap, stamped as shown in the diagram, 24" below the surface in a wheat field on top of a ridge west of McKay Creek.

I set four 5/8" by 24" rebars with 1.25" red plastic caps stamped ORLS 852 and WALS 13922 as described below:

- a rebar bears S00°04'E, 48.15 feet 2' below the surface;
- a rebar bears S87°42'E, 49.17 feet 2' below the surface;
- a rebar bears N00°07'E, 50.48 feet 2' below the surface;
- a rebar bears S89°36'W, 47.61 feet 2' below the surface;

The bearings are true.

This work was done June 10, 1997, and witnessed by Stephen K. Haddock.

Office of _____, I hereby certify that the within instrument was filed
 State of _____
 in this office for record on the _____ day of _____ by _____
 _____ (COUNTY OFFICIAL) (DEPUTY)

REGISTERED PROFESSIONAL LAND SURVEYOR

David L. Haddock

OREGON JULY 12, 1996 DAVID L. HADDOCK 882

RECEIVED BY
 Umatilla County Surveyor
 Date: 7-97
 Rec'd By: [Signature]
 No: 97-140-C