


OREGON CORNER RESTORATION FORM

Section 4 Township 1S Range 32E
 County Umatilla Date: December 11, 2015

Corner Designation: 1S32C9 Condition Report Only
 Not found
 Quarter corner to sections 4 and 5, T1S, R32E, W.M. x Remonumented
 Umatilla County, Oregon. x Unrecorded
x Surveyed in
x Referenced out

Previous Renewals / Surveys, etc.
 The corner was originally set by Daniel Chaplin under contract No. 107 dated September 21, 1864. His record reads: Set post for 1/4 Sec. Cor., in mound of earth, with charred stake, pits, etc., as per instructions. In 1973 under survey I-44-B, Donald Staebler set a 2" iron pipe by proportion using the record notes dimension which was different from the plat. There being no evidence to discern between the plat or notes at this corner, I have held Staebler's position.

Monument and Accessories found: (condition and source)
 None. This position falls in the east track of a gravel field road.

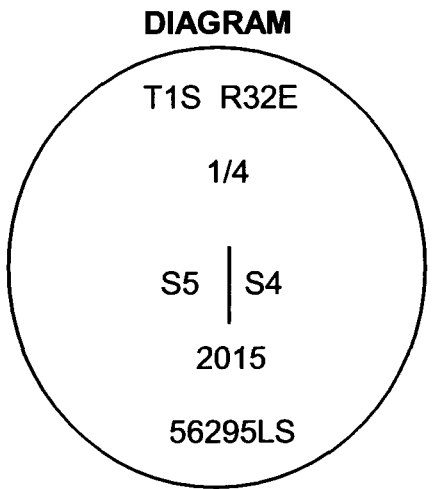

A hand-drawn sketch showing a north-south orientation. A north arrow points upwards. To the right, a vertical line represents a fence with 'x' marks. A 'Fence Brace' is indicated as being approximately 110 feet north. Below the fence, a dashed line represents a 'Gravel Access Road'. A circle with a dot inside is located on the road, representing the monument location.

⊙ = Brass Cap in East Wheel Track
 ● = Rebar Reference

MONUMENT (S) AND ACCESSORIES SET (Procedures and Description)
 At the position determined from Staebler's survey, I set a 2 1/4" brass cap on a 1 1/2" x 30" galvanized iron pipe stamped as shown in the diagram above 6 inches below the surface of the road.
 For references I set four 5/8" x 24" iron rebars with 1 1/8" orange plastic caps stamped WTS and 56295LS as described below:
 an iron rebar bears N50°15'17"E, 31.14 feet under the existing fence;
 an iron rebar bears N55°07'26"W, 25.07 feet eight inches below the surface;
 an iron rebar bears S49°33'26"E, 30.77 feet under the existing fence;
 an iron rebar bears S47°37'27"W, 26.69 feet 12 inches below the surface;

These references were set and tied using a Trimble R7/R8 RTK GPS

Location and comments RECEIVED BY: Umatilla County Surveyor Date: <u>1/6/2016</u> Rec'd By: <u>G. Jensen</u> No. <u>16-004-R</u>	Compass Declination Firm / Agency Witness Tree Surveying Address P.O. Box G Pilot Rock, Or. 97868 Party Chief Stephen K, Haddock	Surveyors Seal <div style="border: 1px solid black; padding: 5px; text-align: center;"> REGISTERED PROFESSIONAL LAND SURVEYOR </div> <div style="text-align: center; margin-top: 5px;"> <i>Stephen K. Haddock</i> </div> <div style="border: 1px solid black; padding: 5px; text-align: center;"> OREGON JULY 9, 2001 STEPHEN K. HADDOCK 56295LS </div> RENEWS: <u>6-30-17</u>
---	---	--