

OREGON CORNER RESTORATION FORM

E-09

Section 5 Township 1S Range 32E
 County Umatilla Date: August 16, 2019

Corner Designation: 1S32E9

Condition Report Only
 Not found

corner to sections 4, 5, 8, and 9 T1S, R32E W.M.

Remonumented
 Unrecorded
 Surveyed in
 Referenced out


Previous Renewals / Surveys, etc.

Corner originally set by Daniel Chaplin under contract No. 107 Dated September 21, 1864. His record reads: Set post for Cor. to Secs. 4, 5, 8 & 9, in mound of earth with charred stake, pits, etc., as per instructions. In Umatilla County Survey I-44-B Don Staebler states "Set 2" Pipe".


Monument and Accessories found: (condition and source)

The pipe set by Staebler (recently destroyed by Cascade Natural Gas during rebuild of a gas main) was badly bent and discarded in a mound of stone approximately 40' southeast of its original position.

DIAGRAM

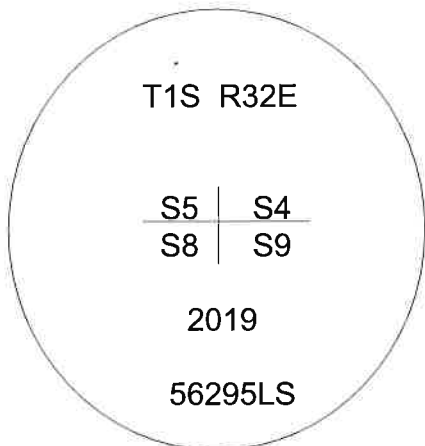

SKETCH

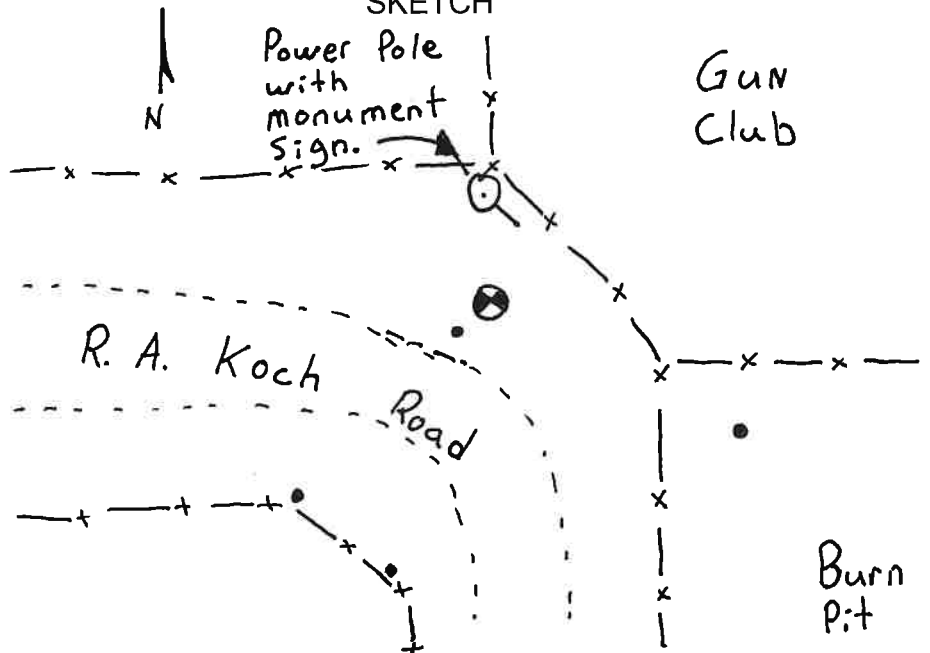

MONUMENT (S) AND ACCESSORIES SET (Procedures and Description)

Set a 1 1/4" x 30" Galvanized Iron Pipe with a 2 1/2" brass cap stamped as shown in the diagram above at the position of Staebler's pipe as tied by me in partitions 2011-22, 2015-07, 2016-01 and 2017-12. The monument is set flush with the gravel directly over the gas main.

For references, a 1/2" iron rebar with a red plastic cap stamped "APA Control bears S72°20'45"E 37.59 feet;

a 1/2" iron rebar 12" below the surface bears S54°25'00"W 4.71 feet, origin unknown;

a 5/8"x20" smooth iron rod stamped 56295LS on the side bears S64°37'58"W 84.02";

a 5/8"x20" smooth iron rod stamped 56295LS on the side bears S23°37'35"W 85.38";

The monument was set and references tied using a Trimble R7/R8 RTK GPS system.

Location and comments

Compass Declination

Surveyors Seal

RECEIVED BY:

Umatilla County Surveyor

Date:

Rec'd By:

No.

Firm / Agency

Witness Tree Surveying

Address

P.O. Box G

Pilot Rock, OR 97868

Party Chief

Stephen K, Haddock

REGISTERED
 PROFESSIONAL
 LAND SURVEYOR

Stephen K. Haddock

OREGON
 JULY 9, 2001
 STEPHEN K. HADDOCK
 56295LS

RENEWS: 6-30-21

19-101-8