

**OREGON CORNER REFORMATION FORM**

Section 14 Township 1S Range 32E  
 County Umatilla Date: September 14, 2007

Corner Designation: 1S32J19

Condition Report Only  
 Not found  
 Remonumented  
 Unrecorded  
 Surveyed in  
 Referenced out

Quarter corner common to sections 11 and 14, T1S, R32E,  
 W.M., Umatilla County, Oregon.


Previous Renewals / Surveys, etc.

Corner originally set by Daniel Chaplin under contract No. 107 dated September 21, 1864. His record reads: Set post for 1/4 Sec. Cor., in mound of earth, with pits, charred stake, etc., as per instructions. James Currin and James Noland, under special instructions dated May 4, 1887, state: Found a stone, 6 x 6 x 4 ins. above ground. Dug pits 18x18x12 ins., 5 1/2 foot dist. and raised earth mound 1 1/2 ft. high by 3 1/2 ft. base along side.

Monument and Accessories found: ( condition and source )


A fence along the north - south centerline of section 11 and an old fence corner on the centerline of section 14.

**DIAGRAM**

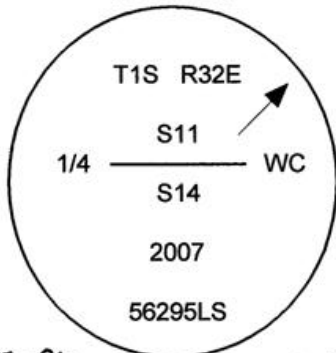

- ☐ = PK with Copper Washer
- ⊙ = 1" Rebar w/al. cap
- = Rebar Reference

**SKETCH**

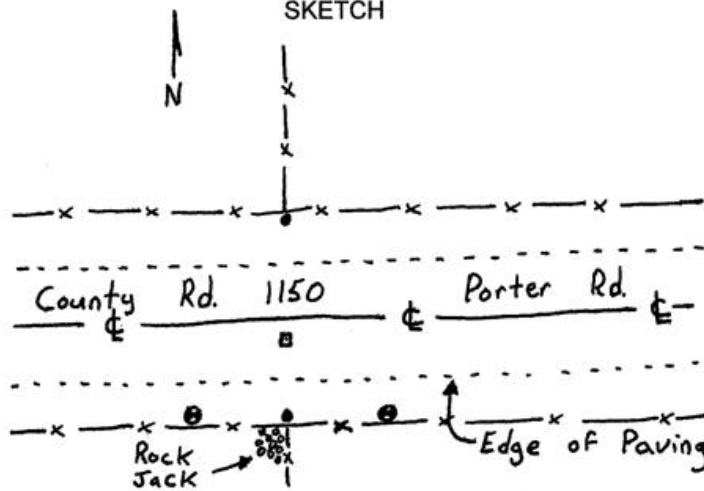

**MONUMENT (S) AND ACCESSORIES SET (Procedures and Description)**

At the intersection of the north - south fence line and the east - west section line, I set a PK nail with a 1 1/8" copper washer stamped WTS and 56295LS in the asphalt of the County Road.

For references, I set two 5/8" by 24" rebars with 1.25" orange plastic caps stamped WTS and 56295LS under the existing fences as described below:

- an iron rebar bears N0°18'29"E, 36.32 feet;
- an iron rebar bears S0°52'56"W, 22.36 feet;

I set two 1"x24" iron rebars with 2" al caps stamped as shown in the diagram above for witness monuments.

- an iron rebar bears S43°46'23"E, 30.36 feet;
- an iron rebar bears S46°12'32"W, 32.76 feet;

The monument and references were tied using a Trimble R7/R8 RTK GPS.

Location and comments

Compass Declination

Surveyors Seal

RECEIVED BY:  
Umatilla County Surveyor  
 Date: 10-07  
 Rec'd By: KK  
 No. 07-268-B

Firm / Agency  
 Witness Tree Surveying  
 Address  
 P.O. Box G  
 Pilot Rock, Or. 97868  
 Party Chief  
 Stephen K, Haddock

REGISTERED  
 PROFESSIONAL  
 LAND SURVEYOR

*Stephen K. Haddock*

OREGON  
 JULY 9, 2001  
 STEPHEN K. HADDOCK  
 56295LS

RENEWAL DATE 6-30-09