

OREGON CORNER RECONSTRUCTION FORM

Section 17 Township 1S Range 32E
 County Umatilla Date: September 2, 2003

Corner Designation: 1S32L9

Common quarter corner to sections 16 and 17, T1S, R32E, W.M., Umatilla County, Oregon.


Previous Renewals / Surveys, etc.

Corner originally set by Daniel Chaplin under contract No. 107 dated Sept 21, 1864. His record reads: Set post for 1/4 Sec. Cor., in mound of earth, with charred stake, pits, etc., as per instructions.

Condition Report Only
 Not found
 Remonumented
 Unrecorded
 Surveyed in
 Referenced out

Monument and Accessories found: (condition and source)

I found a concrete ball with a 3/4in iron pipe running horizontally through it. Long time Pilot Rock resident Bill Etter SR. told me that he had witnessed this monument being disturbed during flood cleanup of the schoolyard. The pipe bears N34°30'46"W, 3.31ft.

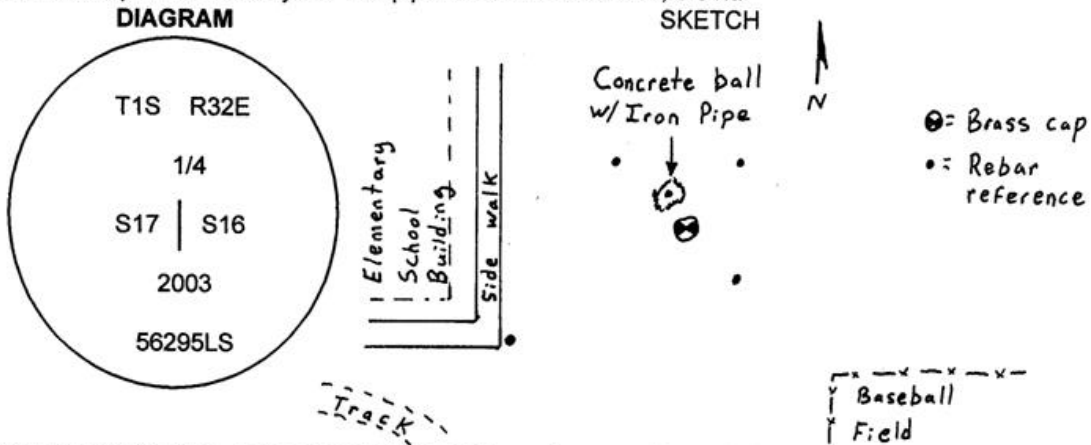

MONUMENT (S) AND ACCESSORIES SET (Procedures and Description)

I set a 1 1/2" x 30" galvanized iron pipe with a 2 1/4" brass cap stamped as shown in the diagram above. The monument was set at the correct position based on ties to the monuments of the Mcdevitts Addition, plat book 7, page 33.

For references, I set four 5/8" by 24" green coated iron rebars with 1 1/8" orange plastic caps stamped WTS and 56295LS as described below:

- a rebar bears N41°58'24"W, 30.92 feet;
- a rebar bears N44°09'25"E, 31.63 feet;
- a rebar bears S54°51'34"E, 32.61 feet;
- a rebar bears S54°30'45"W, 73.84 feet;

The monument and references were tied using a LIECA system 300 RTK GPS.

Location and comments

NAD 83-91 coordinates from GPS ties to Tri Stations Birch and Alkali.
 N 665184.47'
 E 8629695.90'
 Witnessed by Matt Jensen
RECEIVED BY:
Umatilla County Surveyor
 Date: 3-04
 Rec'd By: KK
 No. 04-70-B

Compass Declination
 Firm / Agency
 Witness Tree Surveying
 Address
 P.O. Box G
 Pilot Rock, Or. 97868
 Party Chief
 Stephen K, Haddock
 Witness: Matt Jensen

Surveyors Seal

REGISTERED
 PROFESSIONAL
 LAND SURVEYOR

Stephen K. Haddock

OREGON
 JULY 9, 2001
 STEPHEN K. HADDOCK
 56295LS

RENEWAL DATE 6-30-05