

OREGON CORNER RESTORATION FORM

Section 13 Township 1S Range 32E
 County Umatilla Date: September 13, 2007

Corner Designation: 1S32N25



East corner to sections 13 and 24, T1S, R32E,
 W.M., Umatilla County, Oregon.

Condition Report Only
 Not found
 Remonumented
 Unrecorded
 Surveyed in
 Referenced out

Previous Renewals / Surveys, etc.

Corner originally set by David P. Thompson under contract 106 dated August 16, 1864. His record reads: Set post for cor. to secs. 13, 18, 19 & 24, in mound of earth, with charred stake, pits, trench, etc., as per instructions. Zenas Moody, under contract 164 dated October 4, 1871 states: Set stone 17x14x10 for Cor. to Secs. 13, 24, 18 & 19. James Currin and James Noland, under special Instructions dated May 4, 1887, state: Found Cor. to Secs. 13 & 24, a charred stake, in earth mound with pits. Set a basalt stone, 14x14x12 ins., 9 ins. in ground for Cor. to secs. 13 & 24, marked, 3 notches on N. & S. edges. Dug pits, 18x18x12 ins. N., S., and W. of Cor. 5 1/2 ft. dist. Raised earth mound 2 ft. high, 4 1/2' base along side.

Monument and Accessories found: (condition and source)
 The stone set by Currin and Noland firmly set over the top of a decayed post.

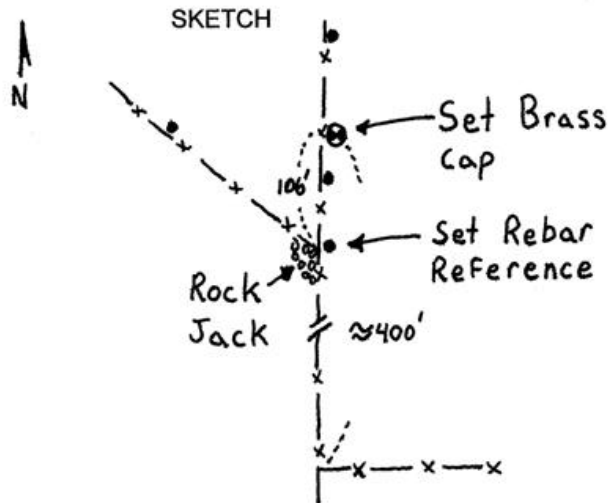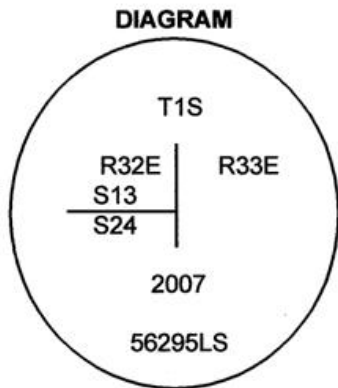

MONUMENT (S) AND ACCESSORIES SET (Procedures and Description)

Set a 1 1/4" x 30" Galvanized Iron Pipe with a 2 1/2" brass cap stamped as shown in the diagram above at the position of the original post. I buried the stone along the north side of the pipe.

For references, I set four 5/8" by 24" rebars with 1.25" orange plastic caps stamped WTS and 56295LS as described below:

- an iron rebar bears N0°13'29"E, 59.89 feet under what appears to be the stone by Moody;
- an iron rebar bears S1°49'19"W, 68.60 feet;
- an iron rebar bears S1°31'16"W, 103.72 feet;
- an iron rebar bears S82°43'46"W, 225.90 feet;

The monument and references were tied using a TRIMBLE R7/R8 RTK GPS system.

Location and comments

Compass Declination

Surveyors Seal

RECEIVED BY:
Umatilla County Surveyor
 Date: 10-07
 Rec'd By: KK
 No. 07-268-B

Firm / Agency
 Witness Tree Surveying
 Address
 P.O. Box G
 Pilot Rock, Or. 97868
 Party Chief
 Stephen K. Haddock

REGISTERED
 PROFESSIONAL
 LAND SURVEYOR

Stephen K. Haddock

OREGON
 JULY 9, 2001
 STEPHEN K. HADDOCK
 56295LS

RENEWAL DATE 6-30-09