

OREGON CORNER RESTORATION FORM

Section 23 Township 1S Range 32E
County Umatilla Date: February 15, 2019

Corner Designation: 1S32P17

Condition Report Only
Not found _____
Remonumented x
Unrecorded _____
Surveyed in _____
Referenced out x

Common quarter corner to sections 22 and 23, T1S, R32E, W.M., Umatilla County, Oregon.


Previous Renewals / Surveys, etc.

Corner originally set by Daniel Chaplin under contract #107 dated September 21st, 1864. His record reads: Set stone, 18 x 10 x 8 for 1/4 Sec. Cor.; In the Record of Private Surveys Book 1, Page 409, survey No. 110a in 1899, John Kimbrell said "set stone in center of road". In the county road survey for Road No. 292 in 1887, John Arnold reports surveying the road centerline directly along the section line.

Monument and Accessories found: (condition and source)


The center of the county road with long term fences running east and west.

DIAGRAM

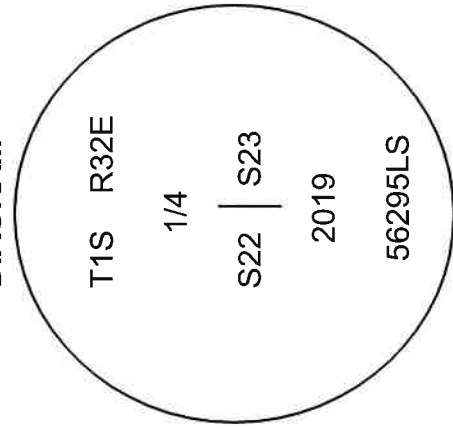

- ⊗ = Aluminum Cap
- = Rebar Reference

SKETCH

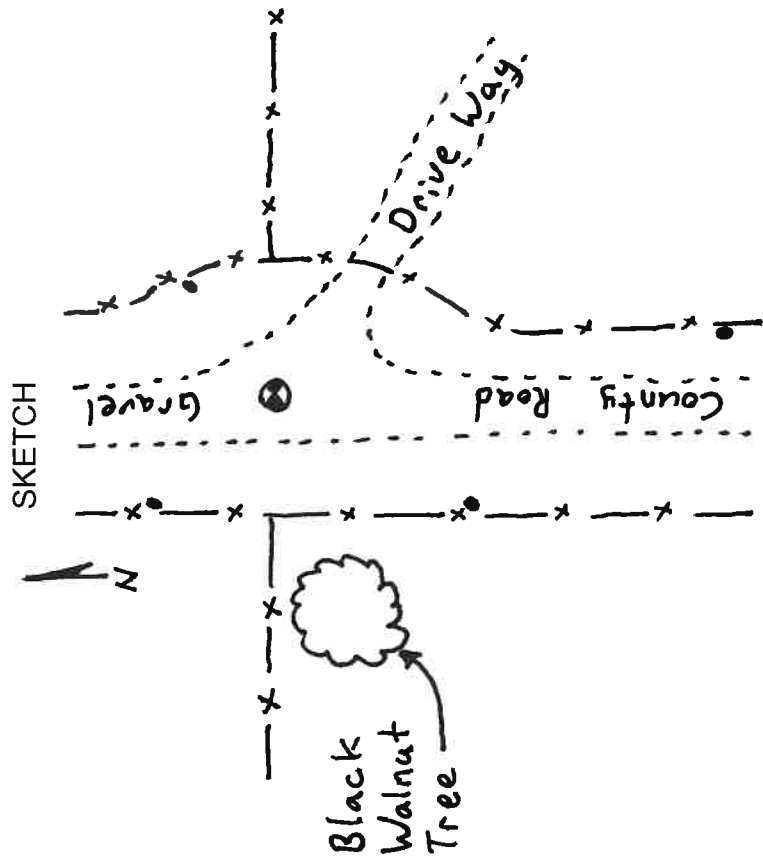

MONUMENT (S) AND ACCESSORIES SET (Procedures and Description)

Set a 2" aluminum cap in a 1 1/2" x 16" galvanized iron pipe 5 inches below the surface of the road. The cap is stamped as shown in the diagram above.

For references, I set four 5/8" by 24" rebars with 1 1/8" orange plastic caps stamped WTS and 56295LS as described below:

- an iron rebar bears N32°26'35"E, 51.23 feet at the foot of a rock jack;
- an iron rebar bears N32°37'00"W, 48.57 feet under the right of way fence;
- an iron rebar bears S30°37'39"W, 52.41 feet under the right of way fence;
- an iron rebar bears S13°53'09"E, 123.03 feet at the foot of the south post of an "H" brace;

The monument and references were tied using a Trimble R7/R8 RTK GPS system.

Location and comments

Compass Declination

Surveyors Seal

RECEIVED BY:
Umatilla County Surveyor
Date: 3/5/19
Rec'd By: CT
No. 19-022-B

Firm / Agency
Witness Tree Surveying
Address
P.O. Box G
Pilot Rock, OR 97868
Party Chief
Stephen K, Haddock

REGISTERED
PROFESSIONAL
LAND SURVEYOR
Stephen K. Haddock
OREGON
JULY 9, 2001
STEPHEN K. HADDOCK
56295LS
RENEWS: 6-30-19