

**OREGON CORNER RELOCATION FORM**

Section 19 Township 1S Range 32E  
 County Umatilla Date: March 24th, 2006



Corner Designation: 1S32P5 Condition Report Only  
 Not found  
 Quarter corner to sections 19 and 20, T1S, R32E, W.M. x Remonumented  
 Umatilla County, Oregon. Unrecorded  
 Surveyed in  
x Referenced out

**Previous Renewals / Surveys, etc.**

Corner originally set by Daniel Chaplin under contract No. 107 dated September 21, 1864.  
 His record reads: Set post for 1/4 sec cor in mound of earth with charred stake, pits &c as per instructions.

**Monument and Accessories found: ( condition and source )**

I found the rotten remains of the original stake approximately 2 feet south of a long term fence corner with fences running south and east. The stake was 3" x 3", squared and charred on all sides.

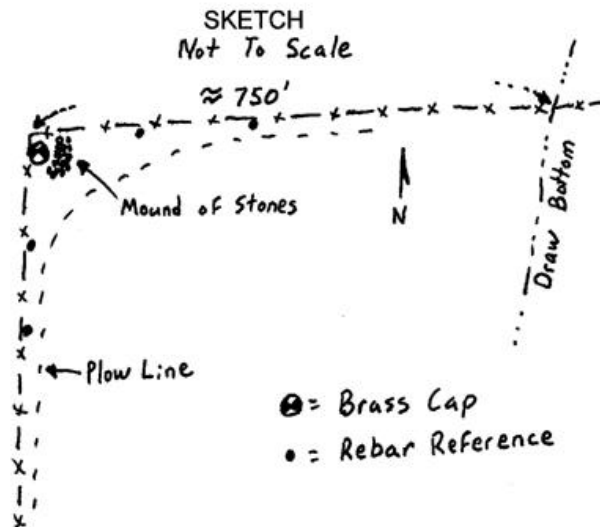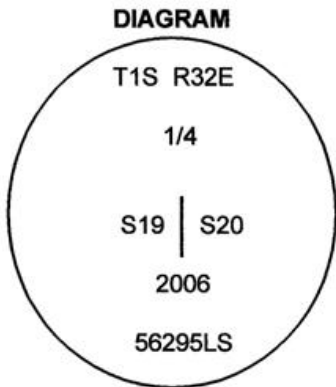

**MONUMENT (S) AND ACCESSORIES SET (Procedures and Description)**

I set a 2 1/2" brass cap on a 1 1/4" x 30" galvanized iron pipe flush with the surface. The cap was stamped as shown in the diagram above. I buried the remains of the original post in a white plastic cup on the north side of the monument.

For references I set four 5/8" x 24" iron rebars with 1 1/8" orange plastic caps stamped WTS and 56295LS as described below:

- an iron rebar bears N84°16'10"E, 19.11 feet on the south side of the existing fence;
- an iron rebar bears N87°55'40"E, 37.73 feet on the south side of the existing fence;
- an iron rebar bears S2°46'18"W, 20.89 feet on the east side of the existing fence;
- an iron rebar bears S1°33'04"S, 44.35 feet on the east side of the existing fence;


The references were tied using a Trimble R7/R8 RTK GPS

Location and comments  
 Corner work was witnessed  
 by Mr. Terry Hamby.


RECEIVED BY:  
Umatilla County Surveyor  
 Date: 4-06  
 Rec'd By: [Signature]  
 No. 06-056-B

Compass Declination  
 Firm / Agency  
 Witness Tree Surveying  
 Address  
 P.O. Box G  
 Pilot Rock, Or. 97868  
 Party Chief  
 Stephen K, Haddock

Surveyors Seal

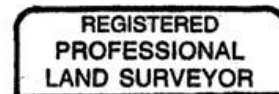

*Stephen K. Haddock*

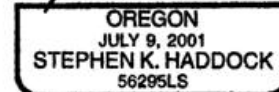

RENEWAL DATE 6-30-07