


CERTIFIED RECORD OF LAND CORNER MONUMENTATION

HISTORY OF ORIGINAL CORNER ESTABLISHED:

None

T 1 S R 34 E D-25

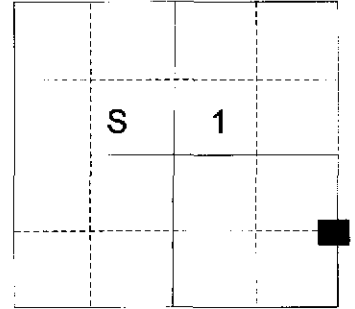

DESCRIPTION OF CORNER EVIDENCE FOUND:

None

DESCRIPTION OF MONUMENT AND ACCESSORIES I ESTABLISHED TO PERPETUATE THE ORIGINAL LOCATION OF THIS CORNER:

At a position determined by survey, I set a 5/8" x 30" iron pin with a 2 1/2" aluminum cap marked as shown below, 15" in the ground with a mound of stone 2 1/2' base to top of cap.
From which:

NEW BEARING OBJECTS:

A 14" Ponderosa Pine bears S 29° W, a distance of 49.95 feet, marked S 1/16 S1 BT.
A 12" Ponderosa Pine bears N 64° W, a distance of 61.80 feet, marked S 1/16 S1 BT.


I set a steel fencepost approximately 1 foot South of the corner monument.

I hereby certify that this corner was monumented on December 23, 2014.

Witness: Thomas J. Kopp



Renewal Date: June 30, 2015

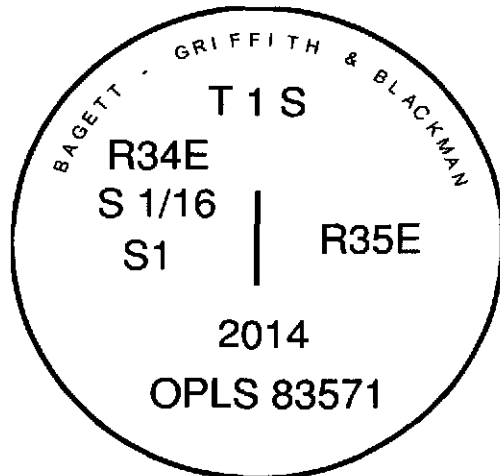

I used a steel tape and magnetic compass in the establishment of the new accessories. I used 16° East declination, the distances are to a 60d spike driven into the right side of the root crown of the new bearing trees. A brass washer marked OPLS 83571 is attached to the BT blaze of the new bearing trees.