


History of original corner establishment:

Original corner established by James E. Noland on July 5, 1887, under special contract, as follows:

Set a post for the corner, from which:

- A 20" pine bears S65°E, 16 links (10.56 feet).
- A 18" pine bears N60°W, 30 links (19.80 feet).

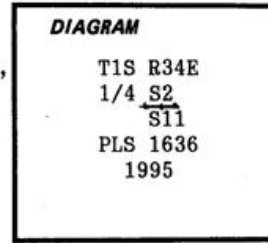

Description of corner evidence found:

A 23" Ponderosa Pine snag with scribes "1/4 S" visible on upper blaze, lower blaze decayed, bears S65°E, 10.6 feet to face.

A badly decayed, sawn Ponderosa Pine stump, no marks remain, bears N60°W, 19.8 feet to face.


Description of monument and accessories established to perpetuate the original location of this corner:

At the corner point as determined by reference to the original bearing tree evidence, set a 1" x 30" iron pipe, 28" into the ground. A 2 1/2" brass cap attached is marked as shown in the diagram above, from which:

- A 11" Western Larch, scribed "1/4 S2 BT", bears N50°E, 28.6 feet.
- A 10" Western Larch, scribed "1/4 S11 BT", bears S87°E, 42.5 feet.
- A 14" Ponderosa Pine, scribed "1/4 S11 BT", bears S77°W, 100.6 feet.
- A 7" White Fir, scribed "1/4 S2 BT", bears N51°W, 20.8 feet.

All four of the new bearing trees are scribed on double blazes, have a 5/8" brass washer, marked "PLS 1636", nailed flush to the lower blaze and have a bearing tree sign nailed above the blazes.

I hereby certify the above corner point was perpetuated as hereon described on November 23, 1995. Magnetic declination: 20°E.

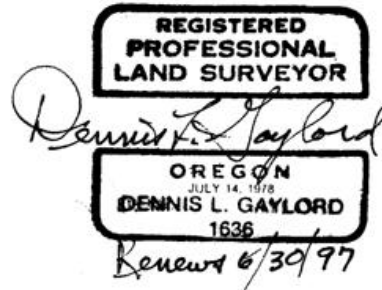

Office of the Survey Dept. County of Umatilla
 State of OREGON, I hereby certify that the within instrument was filed in this office for record on the 28 day of November, 1995
 by (COUNTY OFFICIAL) (DEPUTY)

RECEIVED BY
 Umatilla County Surveyor
 Date 11-25
 Rec'd By KK
 No. 95-205-R