

USDA-FOREST SERVICE

Index  
File No. N-23

CORNER RECORD (SEARCH)


(Ref. FSM 7151.4)

Tract or  
Survey No. \_\_\_\_\_ Cor. No. \_\_\_\_\_

T LS R. 35E R.D. WALLA WALLA County UMATILLA

Merid. WILLAMETTE N.F. UMATILLA State OREGON

CORNER DIAGRAM

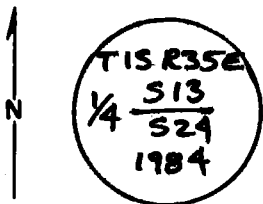

DESCRIBE CORNER MONUMENT FOUND

3 1/4" BLM BRASS CAP ON W 2 1/2" IP RISING 3"

DESCRIBE BEARING TREES OR OTHER OFFICIAL ACCESSORIES FOUND

1 1/2" W. FIR BLAZED & SCRIBED 1/4 513 BT  
BEARS N 31 1/2° W ~ 13 LKS - 8 1/2 FT

8" WESTERN LARCH BLAZED & SCRIBED 1/4 524 BT  
BEARS S 28 1/2° E ~ 7 LKS ? FT

PHOTO IDENTIFICATION DATA

Photo No. \_\_\_\_\_  
Filed At. \_\_\_\_\_  
Object Ident. \_\_\_\_\_  
Ident. By \_\_\_\_\_  
*Signature*

PLANE COORDINATE POSITION DATA

State \_\_\_\_\_ Zone \_\_\_\_\_  
X \_\_\_\_\_  
Y \_\_\_\_\_  
Estab. By \_\_\_\_\_  
*Agency*

DESCRIBE CORNER LOCATION RELATIVE TO NEAR-BY FEATURES, ALSO HOW TO REACH CORNER

TAKE FREEWAY 3 1/4 MILES SE'LY FROM MEACHAM  
WALK 600' NE'LY TO C 1/4 COR 524 FOLLOW  
POSTED LINE NORTH 1/2 MILE TO CORNER.  
CORNER IS 200' ABOVE SHEER CREEK

*Signature*  
*B. Sutton*

Title  
LS 1848

Division

Headquarters

Date  
7-85

7100-52 (3-68)

CORNER RECORD (PERPETUATION)

MONUMENT: DESCRIBE NEW MONUMENT SET, OR WORK DONE TO PRESERVE EXISTING MONUMENT

NONE.

ACCESSORIES: DESCRIBE NEW BT'S WITNESS OBJECTS ETC. ESTABLISHED, OR WORK DONE TO PRESERVE EXISTING EVIDENCE

SET POST 3 FT. EAST FROM CORNER.

ATTACHED SIGNS TO POST & BT'S. PAINTED RED BANDS

Work Done By B.A. SUTTON Title SURVEYOR Date 7-85 State Registration No. LS 1848  
or Agency

Certified Cor. Record Prepared? Yes No  Filed At: \_\_\_\_\_ Date \_\_\_\_\_

REMARKS

Index File No.  
N-23

T. 15 R. 35E W.M.

Tract or Surv. No.

Cor. 1/4 513  
524

USDA-FOREST SERVICE

Index File No. N-23

T 1S R. 35E

Merid. WILL

CORNER RECORD (SEARCH)


(Ref. FSM 7151.4)

Tract or Survey No. \_\_\_\_\_ Cor. No. \_\_\_\_\_

R.D. WALLA WALLA County UMATILLA

N.F. UMATILLA State OREGON

CORNER DIAGRAM

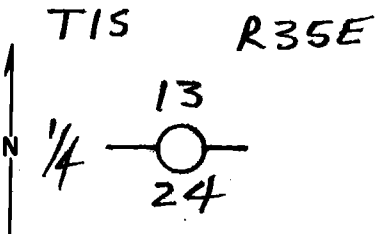

DESCRIBE CORNER MONUMENT FOUND

NONE

DESCRIBE BEARING TREES OR OTHER OFFICIAL ACCESSORIES FOUND

NONE - AREA LOGGED & BURNED

PHOTO IDENTIFICATION DATA

Photo No. \_\_\_\_\_

Filed At. \_\_\_\_\_

Object Ident. \_\_\_\_\_

Ident. By \_\_\_\_\_

*Signature*

PLANE COORDINATE POSITION DATA

State \_\_\_\_\_ Zone \_\_\_\_\_

X \_\_\_\_\_

Y \_\_\_\_\_

Estab. By \_\_\_\_\_

*Agency*

*Signature*

*Title*

*Division*

*Headquarters*

*Date*

7100-52-(3/68)

Dennis L. Gaylord PLS 1636

6-12-82

**CORNER RECORD (PERPETUATION)**

**MONUMENT : DESCRIBE NEW MONUMENT SET, OR WORK DONE TO PRESERVE EXISTING MONUMENT**

**ACCESSORIES : DESCRIBE NEW BT's WITNESS OBJECTS ETC. ESTABLISHED, OR WORK DONE TO PRESERVE EXISTING EVIDENCE**

**Work Done By** \_\_\_\_\_ **Title** \_\_\_\_\_ **Date** \_\_\_\_\_ **State Registration No.**  
**or Agency** \_\_\_\_\_

**Certified Cor. Record Prepared ?** Yes No **Filed At:** \_\_\_\_\_ **Date** \_\_\_\_\_

**REMARKS**

**Index File No.**      **T.**      **R.**      **M.**      **Tract or Surv. No.**      **Cor.**