

USDA-FOREST SERVICE

Index File No. 0-24

CORNER RECORD (SEARCH)

(Ref. FSM 7151.4)

Tract or Survey No. \_\_\_\_\_

Cor. No. \_\_\_\_\_


T 1S R. 3SE

R.D. WALLA WALLA County UMATILLA

Merid. W.M.

N.F. UMATILLA State OREGON

CORNER DIAGRAM

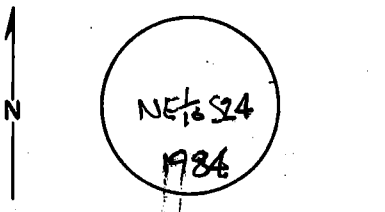

DESCRIBE CORNER MONUMENT FOUND

3 1/4" BLM BRASS CAP ON 2 1/2" IP RISING 2" +

DESCRIBE BEARING TREES OR OTHER OFFICIAL ACCESSORIES FOUND

9" W. FIR BLAZED & SCRIBED NE 1/16 S24 BT  
 BEARS N60°W ~ 16 1/2 LKS., 10.8 FT.  
 8" W. FIR BLAZED & SCRIBED NE 1/16 S24 BT  
 BEARS S58 3/4°E ~ 20 LKS, 13.2 FT.

PHOTO IDENTIFICATION DATA

Photo No. \_\_\_\_\_

Filed At. \_\_\_\_\_

Object Ident. \_\_\_\_\_

Ident. By \_\_\_\_\_

*Signature*

PLANE COORDINATE POSITION DATA

State \_\_\_\_\_ Zone \_\_\_\_\_

X \_\_\_\_\_

Y \_\_\_\_\_

Estob. By \_\_\_\_\_

*Agency*

DESCRIBE CORNER LOCATION RELATIVE TO NEAR-BY FEATURES, ALSO HOW TO REACH CORNER

ON E'LY SLOPE 80' ABOVE N-S RAUINE  
 FOLLOW POSTED LINE FROM N 1/4 S24 E 1/4 MILE  
 & SOUTH 1/4 MILE TO CORNER

Signature *B. S. Nelson*

Title 15/1848

Division \_\_\_\_\_

Headquarters \_\_\_\_\_

Date 5-15-85

FS-7100-52 (3/68)

CORNER RECORD (PERPETUATION)

MONUMENT: DESCRIBE NEW MONUMENT SET, OR WORK DONE TO PRESERVE EXISTING MONUMENT

NONE

ACCESSORIES : DESCRIBE NEW BT'S WITNESS OBJECTS ETC. ESTABLISHED, OR WORK DONE TO PRESERVE EXISTING EVIDENCE

SET STEEL FENCE POST 3 FT. NORTH OF CORNER,  
ATTACHED SIGNS TO POST & BT'S. PAINTED RED BANDS

Work Done By B.A. SUTTON Title SURVEYOR Date 5-15-85 State Registration No. LS 1848  
or Agency

Certified Cor. Record Prepared? Yes  No  Filed At: \_\_\_\_\_ Date \_\_\_\_\_

REMARKS

Index File No.

T.15

R.35E W.M.

Tract or Surv. No.

Cor.

0-24

GPO: 1982 O-382-659

NE 1/6 S24