

CERTIFIED RECORD OF LAND CORNER MONUMENTATION

HISTORY OF ORIGINAL CORNER ESTABLISHED:

Corner originally established by Rufus S. Moore under GLO contract number 451, dated June 12, 1882. Surveyor General field notes state:

T 1 S R 35 E R-13

Set a post 4 ft. long, 4 ins. sq., 24 ins. in the ground, for cor. to secs. 21, 22, 27, and 28 150 ft. above dry gulch marked T1SR35ES22 on NE, T1SR35ES21 on NW, S28 on SW and S27 on SE faces with 2 notches on S. and 3 notches on E. edges from which:

	S	21	

- A pine 30 ins. in dia. bears N37°E 42 lks. dist. marked T1SR35ES22BT.
- A pine 32 ins. in dia. bears N8°W 17 lks. dist. marked T1SR35ES21BT.
- A tamarack 5 ins. in dia. bears S43°W 41 lks. dist. marked T1SR35ES28BT.
- A pine 26 ins. in dia. bears S62°E 44 lks. dist. marked T1SR35ES27BT.

Corner found in August, 1981 by Dennis Gaylord. Corner Card Record states:
 Found Mound of stones
 Decayed stump w/ sliver of wood w/ scribes visible bears N8°W, 11.2 ft.
 Decayed stump w/ scribing visible bears N37°E, 27.7 ft.
 Sawn pine stump w/ scribing visible bears S62°E, 27.1 ft.
 Tamarack is gone.
 Placed BT signs on all stumps

DESCRIPTION OF CORNER EVIDENCE FOUND:

Found a 2' diam. mound of red painted stone.
 A loose lying 18" diam. and 4' tall rotted stob with root ball bears North 67° East, a dist. of 15.75, with scribes visible. Stump has been disturbed and its original position unascertainable.

DESCRIPTION OF MONUMENT AND ACCESSORIES I ESTABLISHED TO MONUMENT THE

LOCATION OF THIS CORNER:



At position of found mound of stone I set a 2 1/2" x 30" aluminum pipe 26" in the ground, with 3" aluminum cap marked as shown below, in a 2' collar of stone, from which:

NEW BEARING OBJECTS:

- A 5" Tamarack bears North 63° East a dist. of 4.75 ft., marked T1SR35ES22BT.
- A 7" White Fir bears South 54° East a dist. of 15.10 ft., marked T1SR35ES21BT.
- A 16" White Fir bears South 16° West a dist. of 10.85 ft., marked T1SR35ES28BT.
- A 5" Ponderosa Pine bears North 5° West a dist. of 5.45 ft., marked T1SR35ES21BT.

Set steel fence post approx. 1 ft. North
 K tag on East/West running forest spur road bears South approx. 150'.

I hereby certify that the corner was monumented on June 18, 2019.
 Witness: Kyle A. Tucker

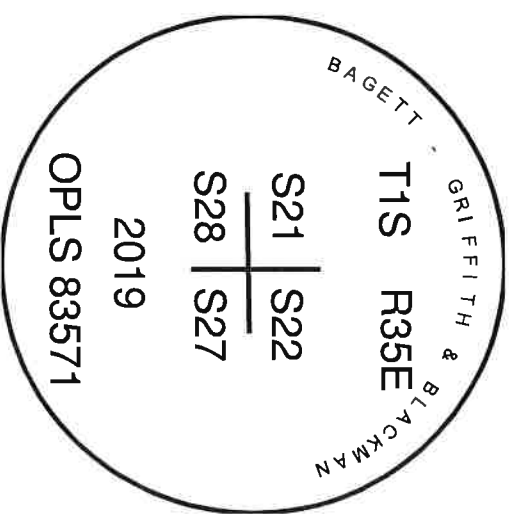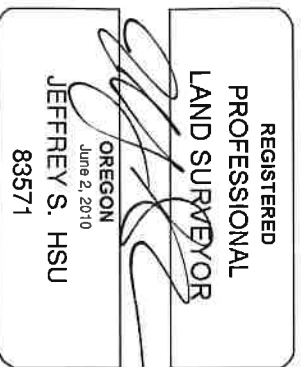

I used a steel tape and magnetic compass in the establishment of the new accessories. I used 13° East declination, the distances are to a 60d spike driven into the side of the root crown of the bearing trees. A brass washer marked OPLS 83571 is attached to the BT blaze of the new bearing trees.

Renewal Date: June 30, 2021