


**CERTIFIED RECORD OF LAND CORNER MONUMENTATION**

**HISTORY OF ORIGINAL CORNER ESTABLISHED:**

Corner originally established by James Currin and James Noland under GIO special contract dated May 4th, 1887. Amended Surveyor General field notes state:

Set a post 4 ft long, 4 in. square, 24 ins. in the ground for closing cor. on U.R. Bdy. marked U.R.C.C. on W. face, T1S R35E S38 on S and S21 on N faces, from which:

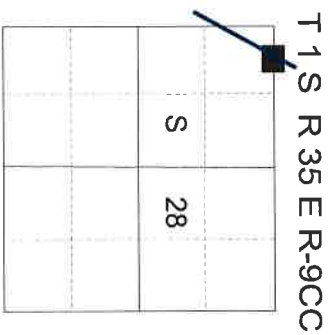

A Pine 24 ins in diam bears N 60° E 70 lks dist. marked UR BT.

A Pine 8 ins in diam bears S 15° E 55 lks dist. marked UR

BT.

A Pine 16 ins in diam bears S 45° W 25 lks dist. marked UR

BT.

A Pine 36 ins in diam bears N 20° W 66 lks dist. marked UR BT.

Corner monumented by Wayne Harris in 1975. Umatilla County survey record M-46-C states "Brass Cap Set".

**DESCRIPTION OF CORNER EVIDENCE FOUND:**

Found a 2 ¼" iron pipe, 16" above ground with 2 ¼" brass cap from which:

A 25" diam. Ponderosa Pine bears South 39° West a dist. of 16.15 ft., alive and vigorous with fragmentary scribing visible on opened blaze.

A 42" diam. Ponderosa Pine bears North 25° West a dist. of 44.00 ft., alive and vigorous with hatchet marks visible on healed blaze.

**DESCRIPTION OF MONUMENT AND ACCESSORIES I ESTABLISHED TO PERPETUATE THE ORIGINAL LOCATION OF THIS CORNER:**

**NEW BEARING OBJECTS:**


A 16" diam. Ponderosa Pine bears North 60° East a dist. of 14.95 ft., marked T1SR35ECCS21 BT.

I hereby certify that the corner was perpetuated on June 4, 2019.  
Witness: Kyle A. Tucker

Fence corner to West, and North East bearing fences bears approx. 20' Southwest.



Renewal Date: June 30, 2021

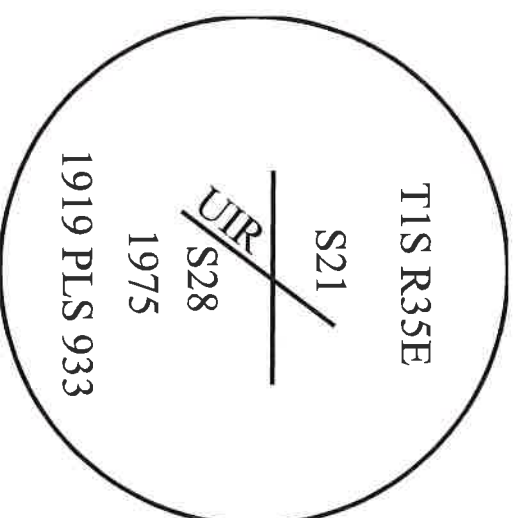

I used a steel tape and magnetic compass in the establishment of the new accessories. I used 13° East declination, the distances are to a 60d spike driven into the right side of the root crown of the bearing trees. A brass washer marked OPLS 83571 is attached to the BT blaze of the new bearing trees.