

CERTIFIED RECORD OF LAND CORNER MONUMENTATION

HISTORY OF ORIGINAL CORNER ESTABLISHED:

Corner originally established by James Currin and James Noland under GIO special contract, dated May 4th, 1887. Surveyor General field notes state:

To U.R. Bdy. 11.55 chs. S20°W of 54 ½ M. post on U.R. Bdy. faced the 4 sides of a fir tree 10in. in diam. for closing cor. and marked U.R. C.C. on North face. No trees in limits and I raised a mound of stone alongside of tree cor.

T 1 S R 35 E S-9 CC

	S	
	28	

DESCRIPTION OF CORNER EVIDENCE FOUND:

None.

A 1 ½" iron pipe for the North 1/16th between S28 and S29 set by Palmer in Survey M-046-C bears North 32° East a dist. of 28.34 ft. Blaze lines bears North and West of said monument.

DESCRIPTION OF MONUMENT AND ACCESSORIES I ESTABLISHED TO MONUMENT THE LOCATION OF THIS CORNER:

At position by survey I set a 5/8"x30" iron pin 28" in the ground with 2 1/2" aluminum cap marked as shown below, in a 1.5' collar of stone, from which:


NEW BEARING OBJECTS:

A 19" Ponderosa Pine bears South 75° East a dist. of 5.20 ft., marked CC S28 BT.
Set steel fence post approx. 1 ft. South

I hereby certify that the corner was monumented on August 5, 2019.
Witness: Kyle A. Tucker



Renewal Date: June 30, 2021

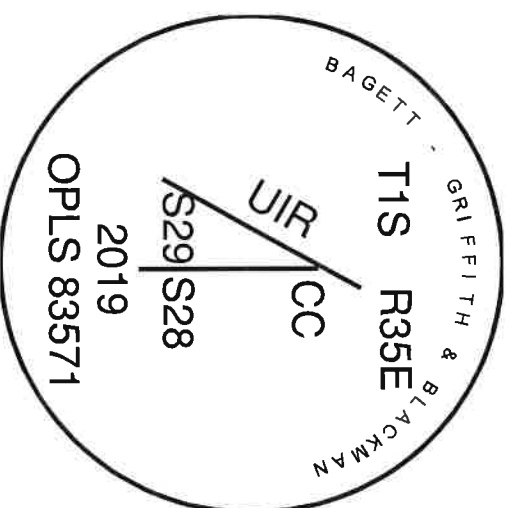

I used a steel tape and magnetic compass in the establishment of the new accessories. I used 13° East declination, the distance is to a 60d spike driven into the side of the root crown of the bearing tree. A brass washer marked OPLS 83571 is attached to the BT blaze of the new bearing tree. Distance and bearing is measured to the center of the brass cap.

S-9 CC

19-079-B