


**CERTIFIED RECORD OF LAND CORNER MONUMENTATION**

**HISTORY OF ORIGINAL CORNER ESTABLISHED:**

Corner originally established under GLO contract number 451 executed by Rufus Moore, dated June 12, 1882. Surveyor General field notes state: Cor. to secs 2 and 3, which is a post 4 ins. sq. marked T1SS35 on NE, R35E2 on SE, T2SS3 on SW, and S34 on NW, from which:  
A Pine 18 ins. diam bears S 56° W 17 lks dist. marked T2S R35E S3 BT.  
A Pine 9 ins. diam bears S 42° E 21 lks dist. marked T2S R35E S2 BT.  
A Pine 11 ins. diam bears N 15° W 19 lks dist. marked T1S R35E S34 BT.  
A Pine 9 ins. diam bears N 17° E 19 lks dist. marked T1S R35E S35 BT.

T 1 S R 35 E Z-13

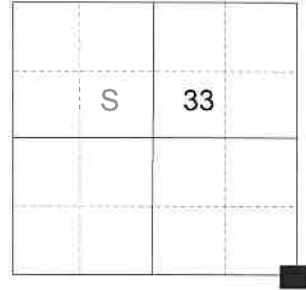

Under GLO contract number 635 executed by Manius Buchanan and dated April 19, 1895. Surveyor General Field notes state: Found the corner badly burned and marks scarcely legible and therefore re-establish it: Set a Tamarac post, 3 ft. long, 4 ins. sq., 24 ins. in ground for closing corner to secs. 33 and 34 marked:  
CCT1SR35E on N, S34 on E, and S33 on W., from which:  
A Tamarac 17 ins. diam. bears N13°E 82 lks. dist. marked T1SR35ES34BT  
A Tamarac 14 ins. diam. bears N70°W 110 lks. dist. marked T1SR35ES33BT

In Survey # M-46, dated 1975, C.T. Palmer finds the bearing trees and sets a tack in hub.

In Umatilla County Monumentation Record 91-77-R Andrew Blachly finds the corner. states: Found 14" long, 3" dia., 18" deep, pointed wood stake. A 14" Tamarack scribed R35ESBT bears N13°E 82 lks. with scribes "R35E S BT" visible on partially healed blaze. A stump bears N70°W 110 lks. with backcast of scribing (very little remaining of tree). Drove 5/8" iron rod with aluminum cap through center of existing GLO post remains. Drove 5/8" iron rod with aluminum cap through center of existing GLO bearing tree remains, which rod bears N73°05'W 73.09 feet. Tack in Hub bears N1°52'E 1.27 feet.  
Set New Accessories:  
Orange Carsonite set 2 feet South of Corner  
16" White Fir N23°W 64.5' Scribed T1SR35ES33CCBT  
15" Tamarack N10°W 83.2' Scribed T1SR35ES33CCBT  
14" White Fir N50°E 41.5' Scribed T1SR35ES34CCBT


**DESCRIPTION OF CORNER EVIDENCE FOUND:**

Found 5/8" iron rod, flush with ground, with 2 1/2" aluminum cap marked as shown below from which:  
A 16" Western Larch bears North 10° West, a dist. of 83.20 ft., dead and standing with scribes visible on partially healed blaze.  
A 14" Western Larch bears North 13° East, a dist. of 54.10 ft., dead and down with scribes visible on partially healed and rotted blaze.  
A 5/8" rebar bears North 73° West, a dist. of 73.10, with 2 1/2" aluminum cap marked T1S R35E S33 RM-BT 1991 Oregon State Parks Division.  
An Orange Carsonite post bears approx. 2 ft. South.

Area has been logged extensively and no other sign of bearing trees remain.

**DESCRIPTION OF MONUMENT AND ACCESSORIES I ESTABLISHED TO PERPETUATE THE ORIGINAL LOCATION OF THIS CORNER:**

From the iron pin monument:  
**NEW BEARING OBJECTS:**  
A 4" White Fir bears North 81° East, a dist. of 18.40 ft., marked X BT.  
A 3" Douglas Fir bears North 41° East, a dist. of 17.20 ft., marked X BT.  
A 4" Douglas Fir bears North 26° West, a dist. of 11.00 ft., marked X BT.

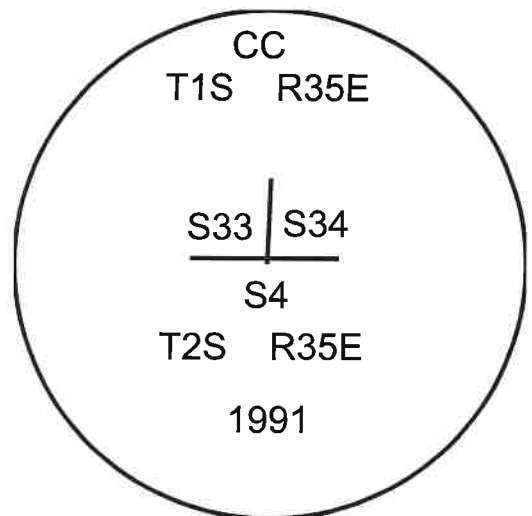

I hereby certify that the corner was perpetuated on November 11, 2021.  
Witness: Kyle A. Tucker



I used a steel tape and magnetic compass in the establishment of the new accessories. I used 14° East declination. Distances are to a 60d spike driven into the right side of the root crown of the bearing trees. Bearings are to a brass washer marked OPLS 83571 in the BT blaze of the new bearing trees.