

USDA-FOREST SERVICE

Index File No. A-25

CORNER RECORD (SEARCH)

(Ref. FSM 7151.4)

Tract or Survey No. \_\_\_\_\_

Cor. No. \_\_\_\_\_


T T2S R. R35E

R.D. WALLA WALLA County UNION / UMATILLA LINE

Merid. WILLAMETTE

N.F. UMATILLA State OREGON

CORNER DIAGRAM

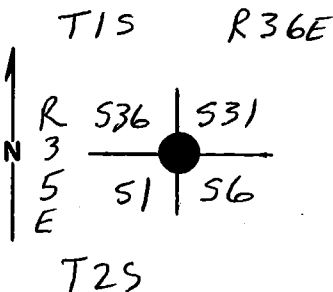

DESCRIBE CORNER MONUMENT FOUND

NONE - SET BY SURVEY;

11" WESTERN LARCH BLAZED & SCRIBED:

"T1S R35E 536" ON NW. "T1S R36E 531" ON NE.

"T2S R35E 51" ON SW. "T2S R36E 56" ON SE.

DESCRIBE BEARING TREES OR OTHER OFFICIAL ACCESSORIES ~~FOUND~~

SET

SCRIBED:

19" FIR S17°W, 19.2ft " T2S R35E 51 BT "

17" FIR S60°E, 25.1ft " T2S R36E 56 BT "

12" W. LARCH N75°E, 16.9ft " T1S R36E 531 BT RS 691 "

11" W. LARCH N65°W, 8.8ft " T1S R35E 536 BT "

DESCRIBE CORNER LOCATION RELATIVE TO NEAR-BY FEATURES, ALSO HOW TO REACH CORNER

PHOTO IDENTIFICATION DATA

Photo No. \_\_\_\_\_

Filed At. \_\_\_\_\_

Object Ident. \_\_\_\_\_

Ident. By \_\_\_\_\_

*Signature*

PLANE COORDINATE POSITION DATA

State \_\_\_\_\_ Zone \_\_\_\_\_

X \_\_\_\_\_

Y \_\_\_\_\_

Estab. By \_\_\_\_\_

*Agency*

Signature

Title

Division

Headquarters

Date

FS-7100-52 (3/68)

JOHN HOLLINGSWORTH

LS 691

SALEM

3-82

**CORNER RECORD (PERPETUATION)**

**MONUMENT : DESCRIBE NEW MONUMENT SET, OR WORK DONE TO PRESERVE EXISTING MONUMENT**

9

**ACCESSORIES : DESCRIBE NEW BT'S WITNESS OBJECTS ETC. ESTABLISHED, OR WORK DONE TO PRESERVE EXISTING EVIDENCE**

10

Work Done By \_\_\_\_\_ Title \_\_\_\_\_ Date \_\_\_\_\_ State Registration No. or Agency \_\_\_\_\_

Certified Cor. Record Prepared ? Yes No Filed At: \_\_\_\_\_ Date \_\_\_\_\_

**REMARKS**

12

Index File No. T. R. M. Tract or Surv. No. Cor. 13