

Index File No. A-11
 T 15 R. 36E
 Merid. Will.

CORNER RECORD (SEARCH)
 (Ref. FSM 7151.4)


Tract or Survey No. _____
 County UMATILLA
 State OR.

Cor. No. _____

R.D. _____

N.F. UMATILLA

CORNER DIAGRAM

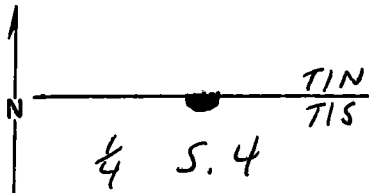

DESCRIBE CORNER MONUMENT FOUND

G.L.O. BRASS DISK SET IN CONCRETE
FLUSH WITH GROUND, MKD. →

TIN R36E

454
TIS R36E
1984²

DESCRIBE BEARING TREES OR OTHER OFFICIAL ACCESSORIES FOUND

9" PINE, SCRIBED "X BT", BEARS S16°W, 145 LBS.
12" PINE, SCRIBED "454 BT" BEARS S35°E, 361 LBS.

DESCRIBE CORNER LOCATION RELATIVE TO NEAR-BY FEATURES, ALSO HOW TO REACH CORNER

COR. LIES ON FLAT, ROCKY, OPEN RIDGE

PHOTO IDENTIFICATION DATA

Photo No. _____
 Filed At. _____
 Object Ident. _____
 Ident. By _____

Signature _____

PLANE COORDINATE POSITION DATA

State _____ Zone _____
 X _____
 Y _____
 Estab. By _____
 Agency _____

Signature Victor McLeod LS

Division _____

Headquarters _____

Date 4-22-86

FS-7100-52 (3/68)

CORNER RECORD (PERPETUATION)

MONUMENT: DESCRIBE NEW MONUMENT SET, OR WORK DONE TO PRESERVE EXISTING MONUMENT

ACCESSORIES : DESCRIBE NEW BT'S WITNESS OBJECTS ETC. ESTABLISHED, OR WORK DONE TO PRESERVE EXISTING EVIDENCE

ATTACHED SIGN 54-4 TO BACK OF BT'S.

PAINTED RED BAND AROUND BT'S

SET STEEL POST ABOUT 4' FROM CORNER, WITH SIGN 54-9

Work Done By. V. McLino Title LS Date 6-3-86 State Registration No. 934
or Agency

Certified Cor. Record Prepared? Yes No Filed At: _____ Date _____

REMARKS

Index File No. A-11 T. 1 S R. 36 E M. WILL Tract or Surv. No. _____ Cor, _____