

Index File No. C-8

T 15 R. 36E

Merid. Will.

CORNER RECORD (SEARCH)

(Ref. FSM 7151.4)


Tract or Survey No. _____

Cor. No. _____

R.D. _____ County UMATILLA

N.F. UMATILLA State OR

CORNER DIAGRAM

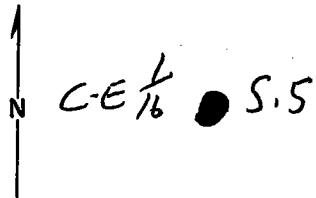

DESCRIBE CORNER MONUMENT FOUND

BLM BRASS DISK SET IN CONC.

ON OPEN, ROCKY S.W. SLOPE, MKD. →

E 1/16

C — C

S 5

1984₂

DESCRIBE BEARING TREES OR OTHER OFFICIAL ACCESSORIES FOUND

11" PINE, SERIATED "CE 1/16 S 5 BT" BEARS N32 1/4° W,
290 LBS.

DESCRIBE CORNER LOCATION RELATIVE TO NEAR-BY FEATURES, ALSO HOW TO REACH CORNER

LIES ON OPEN, ROCKY S.W. SLOPE, ABOUT 300' W.
OF ROAD RUNNING ALONG RIDGE

PHOTO IDENTIFICATION DATA

Photo No. _____

Filed At. _____

Object Ident. _____

Ident. By _____

Signature

6

7

PLANE COORDINATE POSITION DATA

State _____ Zone _____

X _____

Y _____

Estab. By _____

Agency

8

Signature

Victor McFarland

Title LS

Division _____

Headquarters _____

Date

8-16-85

FS-7100-52 (3/68)

4

CORNER RECORD (PERPETUATION)

MONUMENT: DESCRIBE NEW MONUMENT SET, OR WORK DONE TO PRESERVE EXISTING MONUMENT

ACCESSORIES : DESCRIBE NEW BT'S WITNESS OBJECTS ETC. ESTABLISHED, OR WORK DONE TO PRESERVE EXISTING EVIDENCE

ATTACHED SIGN 54-4 TO BACK OF B.T.
PAINTED RED BAND AROUND B.T.

SET STEEL POST ABOUT 3 FT. FROM CORNER WITH SIGN 54-9

Work Done By V. McLIND Title LS Date 6-3-86 State Registration No. 934
or Agency

Certified Cor. Record Prepared ? Yes No Filed At: _____ Date _____

REMARKS

Index File No. C-8 T. 15 R. 36E M. WILL Tract or Surv. No. _____ Cor. _____