


Index
File No. D-9
T 15 R. 36 E
Merid. Will

CORNER RECORD (SEARCH)
(Ref. FSM 7151.4)

Tract or
Survey No. _____
Cor. No. _____

R.D. _____ County UMATILLA
N.F. UMATILLA State OR

CORNER DIAGRAM

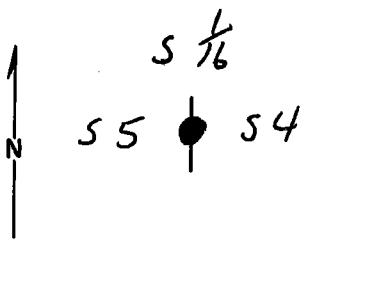

DESCRIBE CORNER MONUMENT FOUND

$2\frac{1}{2}$ " GALV. IRON PIPE WITH BLM BRASS CAP, $S \frac{1}{6}$
MKD. AS SHOWN \rightarrow $S 5 \quad S 4$
1984²

DESCRIBE BEARING TREES OR OTHER OFFICIAL ACCESSORIES FOUND

11" PINE, SCRIBED $S \frac{1}{6} S 5$ BT BEARS $S 23\frac{1}{4} W$, 12 LKS.
22" PINE, SCRIBED $S \frac{1}{6} S 4$ BT BEARS $S 74 E$, 15 LKS.

DESCRIBE CORNER LOCATION RELATIVE TO NEAR-BY FEATURES, ALSO HOW TO REACH CORNER

COR. LIES ON STEEP S.E. SLOPE, IN LIGHT TIMBER

PHOTO IDENTIFICATION DATA

Photo No. _____
Filed At. _____
Object Ident. _____
Ident. By _____

Signature _____

PLANE COORDINATE POSITION DATA

State _____ Zone _____
X _____
Y _____
Estab. By _____
Agency _____

Signature John Michael

Title L.S.

Division _____

Headquarters _____

Date 8-16-85

FS-7100-52 (3/68)

CORNER RECORD (PERPETUATION)

MONUMENT: DESCRIBE NEW MONUMENT SET, OR WORK DONE TO PRESERVE EXISTING MONUMENT

ACCESSORIES : DESCRIBE NEW BT'S WITNESS OBJECTS ETC. ESTABLISHED, OR WORK DONE TO PRESERVE EXISTING EVIDENCE

ATTACHED SIGNS 54-4 TO BACK OF BT'S
PAINTED RED BANDS AROUND BT'S

SET STEEL POST ABOUT 3 FT. FROM CORNER WITH SIGN 54-9

Work Done By. V. McLINO Title LS Date 6-3-86 State Registration No. 934
or Agency

Certified Cor. Record Prepared ? Yes No Filed At: _____ Date _____

REMARKS