


Index
File No. E-9

CORNER RECORD (SEARCH)
(Ref. FSM 7151.4)

Tract or
Survey No. _____
Cor.
No. _____

T 15 R. 36E R.D. _____ County UMATILLA
Merid. Will. N.F. UMATILLA State OR.

CORNER DIAGRAM

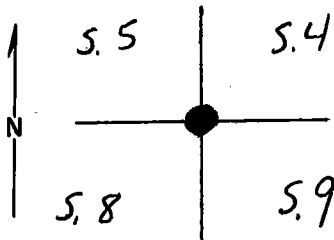

DESCRIBE CORNER MONUMENT FOUND

2 1/2" GALV. IRON PIPE WITH BLM BRASS CAP T15 R36E
MKD. → 55 | 54
58 | 59
1984

DESCRIBE BEARING TREES OR OTHER OFFICIAL ACCESSORIES FOUND

16" FIR, SCRIBED "T15 R36E 54BT" BEARS N48 1/2° E, 144 LBS.
10" PINE, PITCHED OVER FACE, BEARS S13° W, 143 LBS.

PHOTO IDENTIFICATION DATA

Photo No. _____
Filed At. _____
Object Ident. _____
Ident. By _____

Signature

PLANE COORDINATE POSITION DATA

State _____ Zone _____
X _____
Y _____
Estab. By _____

Agency

DESCRIBE CORNER LOCATION RELATIVE TO NEAR-BY FEATURES, ALSO HOW TO REACH CORNER

LIES ON STEEP E, SLOPE, IN OPEN AREA.

Signature Dan McInnis Title CS

Division _____ Headquarters _____

Date 6-3-86

CORNER RECORD (PERPETUATION)

MONUMENT: DESCRIBE NEW MONUMENT SET, OR WORK DONE TO PRESERVE EXISTING MONUMENT

ACCESSORIES : DESCRIBE NEW BT'S WITNESS OBJECTS ETC. ESTABLISHED, OR WORK DONE TO PRESERVE EXISTING EVIDENCE

ATTACHED SIGNS 54-4 TO BACK OF BT'S
PAINTED RED BANDS AROUND BT'S
SET STEEL POST ABOUT 3 FT. FROM CORNER WITH SIGN 54-9

Work Done By V. McLinn Title LS Date 6-3-86 State Registration No. 934
or Agency

Certified Cor. Record Prepared ? Yes No Filed At: _____ Date _____

REMARKS

Index File No. E-9 T. 1S R. 36E M. WILL. Tract or Surv. No. _____ Cor. _____