

U. S. Department of Agriculture
FOREST SERVICE


CORNERS OF THE PUBLIC SURVEY

T. 18 R. 36 E W Mer.

Sec Corner common to Sections
7, and 18

Corner consists of a tree noted away (not) in place
State condition no longer existing

Dimensions above ground _____ inches
Sketch grooves, letters, figures, or notches, on proper face or edge.

CARDINAL POSITION

DIAGONAL POSITION

N	W	S	E

NW	SW	SE	NE

Mound of _____ is located _____

Pits are located _____

Sketch markings of Bearing Trees (or Rocks) in proper box and fill blanks below, giving bearings from Corner to Trees and Distances in Links.

			<u>35 E</u> <u>S 7</u>
			<u>BT</u>

Species This is only an old DF

Diameter stump nearly rotted 27

Bearing and gone but scribbling

Distance as shown could be read


Do you believe this to be a genuine Land Office Corner? _____

If not, why? Field notes say corner was a small tree squared. This has gone but location set by old witness stump.

G. J. Surber
Signature
Aug 11/47 (Date) Dist Ranger (Title)

T. 18 R. 36 E W Mer.

(Make sketch of topography near Corner)

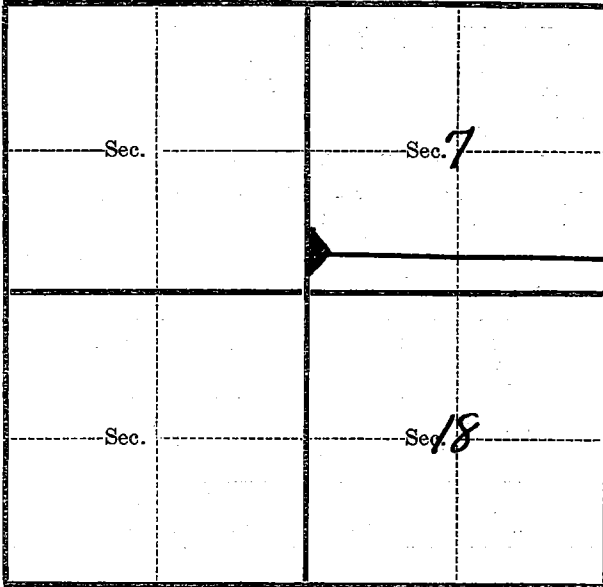

Metal Location Poster is on a L.P.
tree 7 inches diameter, on the opposite
~~side~~ of the corner.
from which this Corner bears _____
_____ chains distant.

Give any further facts which will aid in finding this
Corner again.

Location of corner shown
on Pindilton District aerial
photograph.

CORNER RECORD (SEARCH)

Tract or

Index
File No. J-1

(Ref. FSM 7151.4)

Survey No. _____ No. J-1


T 1S R. 36E

R.D. Pendleton County Umatilla

Merid. Willamette

N.F. Umatilla State Oregon

CORNER DIAGRAM

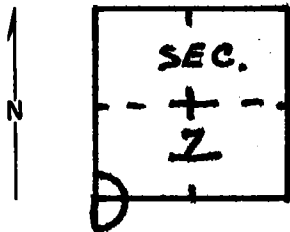

DESCRIBE CORNER MONUMENT FOUND

None.

DESCRIBE BEARING TREES OR OTHER OFFICIAL ACCESSORIES FOUND

North, south and east blaze line. 10" LP pine north side of primitive road has FS location poster imbedded 3" into south side of tree. Poster dated: 9/30/46 WS Road probably obliterated corner.

PHOTO IDENTIFICATION DATA

Photo No. _____
Filed At. _____
Object Ident. _____
Ident. By _____
Signature

DESCRIBE CORNER LOCATION RELATIVE TO NEAR-BY FEATURES, ALSO HOW TO REACH CORNER

PLANE COORDINATE POSITION DATA

State _____ Zone _____
X _____
Y _____
Estab. By _____
Agency

Signature

Bill Moore

Title

Eng, Tech,

Division

Headquarters

Date

10/77

7100-52-(3/68)

CORNER RECORD (PERPETUATION)

GPO 902-673

MONUMENT : DESCRIBE NEW MONUMENT SET, OR WORK DONE TO PRESERVE EXISTING MONUMENT

ACCESSORIES : DESCRIBE NEW BT'S WITNESS OBJECTS ETC. ESTABLISHED, OR WORK DONE TO PRESERVE EXISTING EVIDENCE

Work Done By _____ Title _____ Date _____ State Registration No. _____
or Agency _____

Certified Cor. Record Prepared ? Yes No Filed At: _____ Date _____

REMARKS

Index File No. T. R. M. Tract or Surv. No. Cor.