

Form 874-9—Revised May, 1918

U. S. DEPARTMENT OF AGRICULTURE
FOREST SERVICE

Umatta NATIONAL FOREST

CORNERS OF THE PUBLIC SURVEY

T. 15 R. 36 E W Mer.

Sec. Corner common to Sections
15, 16, 9 and 10

Corner consists of a pile of Rock ~~(not)~~ in place
State condition Fair

Dimensions above ground 8" inches.
Sketch grooves, letters, figures, or notches, on proper face or edge.

CARDINAL POSITION

DIAGONAL POSITION

N W S E

NW SW SE NE

Mound of _____ is located _____

Pits are located _____

Sketch markings of Bearing Trees (or Rocks) in proper box and fill blanks below, giving bearings from Corner to Trees and Distances in Links.

	R36 S16		<u>Survey</u>

Species	<u>L</u>	<u>D.F.</u>	<u>V.P.</u>
Diameter	<u>18"</u>	<u>122"</u>	
Bearing	<u>S36°W</u>	<u>N40°E</u>	
Distance	<u>100.0</u>	<u>71.2</u>	

Do you believe this to be a genuine Land Office Corner? Yes

If not, why? _____


Signature.

Date. Title. 8-3027

T. _____ R. _____ Mer. _____

8-3027

(Make sketch of topography near Corner.)

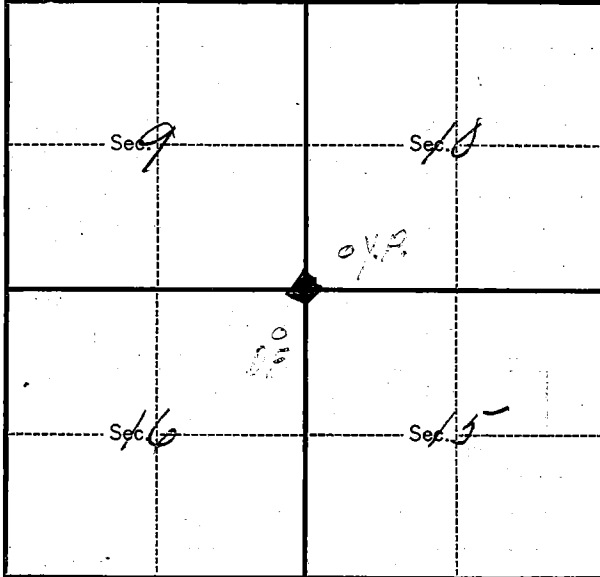

Metal Location Poster is on a _____
tree _____ inches diameter, on the _____
side of _____
from which this Corner bears _____
_____ chains distant.

Give any further facts which will aid in finding this
Corner again.

From D.V. B. & N. track.
N from milepost 256 post
Hbr on 38 chains. BT in
sec 10 is a post in bottom
of small ar-er. BT in sec
16 chopped out. Corner on
sec hillside facing NW. Ch
balew to 20 ridges

USDA-FOREST SERVICE


Index File No. J-13
 T 15 R. 36E
 Merid. Will

CORNER RECORD (SEARCH)

(Ref. FSM 7151.4)

Tract or Survey No. _____ Cor. No. _____
 R.D. WALLA WALLA County UMATILLA
 N.F. UMATILLA State OREGON

CORNER DIAGRAM

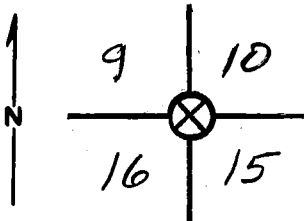

DESCRIBE CORNER MONUMENT FOUND

STONE OF APPROXIMATE RECORD SIZE WITH NO VISIBLE MARKINGS.

DESCRIBE BEARING TREES OR OTHER OFFICIAL ACCESSORIES FOUND

40" ± POND. PINE WITH FULL SCRIBING FAINTLY VISIBLE ON A CHARRED, UNHEALED SINGLE BLAZE BEARS 565°W, APPROX 125 FT. A LARGE DOUG. FIR WITH WHAT APPEARS TO BE A ^{HEALED} LINE BLAZE BEARS NORTH 150 FT. NO OTHER B.T.'S REMAIN.

DESCRIBE CORNER LOCATION RELATIVE TO NEAR-BY FEATURES, ALSO HOW TO REACH CORNER

CORNER IS 1200 FT SW of end of Homeshoe Ridge Road just west of Ridge top.

PHOTO IDENTIFICATION DATA

Photo No. _____
 Filed At. _____
 Object Ident. _____
 Ident. By _____
 Signature _____

PLANE COORDINATE POSITION DATA

State _____ Zone _____
 X _____
 Y _____
 Estab. By _____
 Agency _____

Signature Dennis L. Gaylord Title _____ Division PLS 1636 Headquarters _____ Date 6-12-81 7100-52 (3-68)

CORNER RECORD (PERPETUATION)

MONUMENT: DESCRIBE NEW MONUMENT SET, OR WORK DONE TO PRESERVE EXISTING MONUMENT

ACCESSORIES : DESCRIBE NEW BT'S WITNESS OBJECTS ETC. ESTABLISHED, OR WORK DONE TO PRESERVE EXISTING EVIDENCE

Work Done By _____ Title _____ Date _____ State Registration No. or Agency _____
Certified Cor. Record Prepared? Yes No Filed At: _____ Date _____

REMARKS

Index File No. T. R. M. Tract or Surv. No. Cor.