

Index
File No. N-21

CORNER RECORD (SEARCH)

(Ref. FSM 7151.4)

Tract or
Survey No.

N 21

52 ~~52~~ ~~52~~
Cor. Sec
No.

T 1 S R. 36 E

R.D. Pendleton County

Umatilla


Merid. Willamette

N.F. Umatilla State

Oregon

CORNER DIAGRAM

T1S R36E

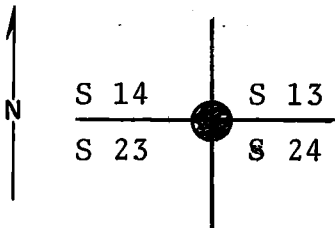

DESCRIBE CORNER MONUMENT FOUND

Brass cap set summer 1972. See reverse side.

DESCRIBE BEARING TREES OR OTHER OFFICIAL ACCESSORIES FOUND

Found 18" fir snag with scribing clearly visible bearing S30°W 86 ft. dist. from corner position.
Found a 15x10x4" basalt stone with 3 faint notches laying flat 1 ft. West from corner position.

PHOTO IDENTIFICATION DATA

Photo No. _____
Filed At. _____
Object Ident. _____
Ident. By _____
Signature

PLANE COORDINATE POSITION DATA

State _____ Zone _____
X _____
Y _____
Estab. By _____
Agency

DESCRIBE CORNER LOCATION RELATIVE TO NEAR-BY FEATURES, ALSO HOW TO REACH CORNER



Signature

Title

Division

Headquarters

Date

7100-52 (3/68)

CORNER RECORD (PERPETUATION)

MONUMENT: DESCRIBE NEW MONUMENT SET, OR WORK DONE TO PRESERVE EXISTING MONUMENT

Set 20x2½" iron pipe with 3" brass cap marked as shown 30" in the ground; and placed original stone North and alongside pipe for the corner to sections 13, 14, 23 & 24 from which BTs:

ACCESSORIES : DESCRIBE NEW BT'S WITNESS OBJECTS ETC. ESTABLISHED, OR WORK DONE TO PRESERVE EXISTING EVIDENCE

A fir 12" in diam. bears N38°E 44 ft. dist. marked T1S R36E S13 BT.

A fir 16" in diam. bears S70°E 36.1 ft. dist. marked T1S R36E S24 BT.

A fir 9" in diam bears S72°W 66.5 Ft. dist. marked T1S R36E S23 BT/

A fir 14" in diam. bears N20°W 12.4 ft. dist. marked T1S R36E S14 BT.

Distances taken to a brass washer in the blaze of each BT. Set a steel fence post approx. 5 ft. East with "Attention" sign attached.

Corner on steep West slope above Owsley Creek. Used steel tape & magnetic compass with declination = 20° East/

Work Done By D. M. Ferguson Title Land Surveyor Date 7/12/68 State Registration No. 848
 or Agency _____

Certified, Cor. Record Prepared? Yes No Filed At: Umatilla Co. Courthouse Date 11/16/72 11

REMARKS