

U. S. Department of Agriculture
FOREST SERVICE

Umatilla NATIONAL FOREST

CORNERS OF THE PUBLIC SURVEY

T. 1 S. R. 36 E. Wm. Mer.
Section Corner common to Sections

19, and 30
Corner consists of a 12 ft. snag (not) in place
State condition rotted

Dimensions above ground inches.

Sketch grooves, letters, figures, or notches, on proper face or edge.

CARDINAL POSITION

DIAGONAL POSITION

N	W	S	E

NW	SW	SE	NE

Mound of _____ is located _____

Pits are located _____

Sketch markings of Bearing Trees (or Rocks) in proper box and fill blanks below, giving bearings from Corner to Trees and Distances in Links.

S			

Species Fir
Diameter 24 24"
Bearing _____
Distance _____

Do you believe this to be a genuine Land Office Corner? ...
If not, why? Yes, original scribe.
Original post in place. Rotted, but scribing evident.


Joe Spertson
(Signature)
DFR

7/12/51
(Date)

(Title)

T. 1 S. R. 36 E. Wm. Mer.

(Make sketch of topography near Corner and show section line markers thus "X")

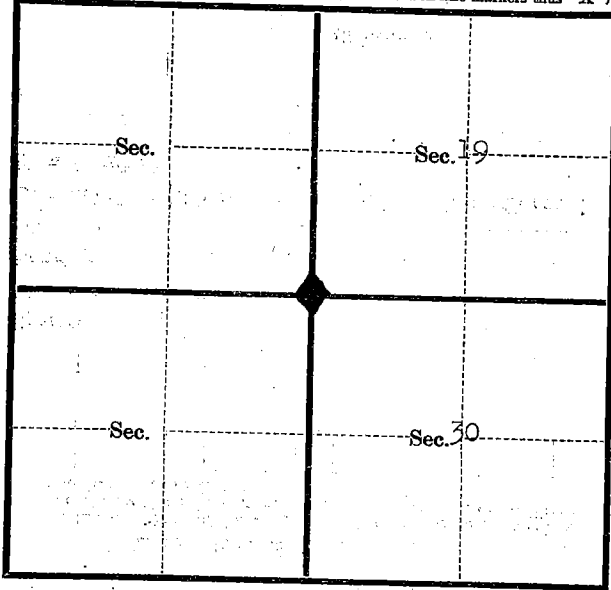

Metal Location Poster is on a lodgepole

tree 8 inches diameter, on the

side of from which

this Corner bears Chains.

(Bearing) (Distance)

Section line marker between Secs. and is on

a on the

(Tree, post, etc.)

(Name of road, trail, etc.)

located chains E., W., N., S., from Sec. Cor.; 1/4 Cor.; Witness Cor.

(Cross out nonapplicable)

Give any further facts needed to find Corner again:

Line blazed.

Index
File No. R-1

CORNER RECORD (SEARCH)

(Ref. FSM 7151.4)

Tract or
Survey No. R 1

Cor. 58 Sec. 2
No. 2


T 1 S R. 36 E

R.D. Pendleton County Umatilla

Merid. Willamette

N.F. Umatilla State Oregon

CORNER DIAGRAM

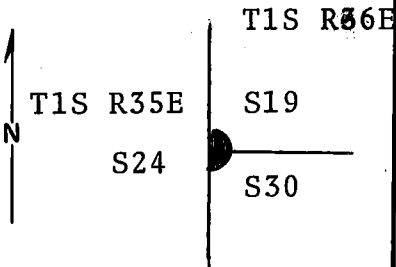

DESCRIBE CORNER MONUMENT FOUND

Set brass cap summer 1972. See reverse side.

DESCRIBE BEARING TREES OR OTHER OFFICIAL ACCESSORIES FOUND

Found a 20" fir stump rotted off at ground level with faint scribing visible, bearing S81°W 15.2 ft. dist. from corner position.

Found rotten remains of a tamarack with scribing visible, bearing S49°E 16.5 ft. dist. from the corner position.

Found the rotten remains fo a tamarack, bearing N47°E

DESCRIBE CORNER LOCATION RELATIVE TO NEAR-BY FEATURES, ALSO HOW TO REACH CORNER

16.5 ft. dist. from the corner position
Found a rotten fir stump, bearing N58°W 9.9 ft. dist. from the corner position.

PHOTO IDENTIFICATION DATA

Photo No. _____
Filed At. _____
Object Ident. _____
Ident. By _____
Signature

PLANE COORDINATE POSITION DATA

State _____ Zone _____
X _____
Y _____
Estab. By _____
Agency



Signature

Title

Division

Headquarters

Date

7100-52 (3/68)

CORNER RECORD (PERPETUATION)

MONUMENT: DESCRIBE NEW MONUMENT SET, OR WORK DONE TO PRESERVE EXISTING MONUMENT

Set a 30x2½" iron pipe with 3" brass cap marked as shown, 28" in the ground for the corner to secs 19, 30, & 24 from which new BTs:

ACCESSORIES : DESCRIBE NEW BT's WITNESS OBJECTS ETC. ESTABLISHED, OR WORK DONE TO PRESERVE EXISTING EVIDENCE

- A tamarack 10" dia. bears N17°E 12.8 ft. dist. marked T18 R36E S19 BT.
- A lodgepole pine 10" dia bears S42°E 12.7 ft. dist. marked T1S R36E S30 BT.
- A ponderosa pine 12" dia. bears S10°W 13.6 ft. dist. marked T1S R35E S24 BT.

All distances taken to a brass washer in the blaze of each tree.

Set a steel fence post approx. 5 ft East from corner with "Attention" sign attached, Used steel tape & magnetic compass with declination = 20°E.

Work Done By: D. M. Ferguson Title: Land Surveyor Date: 7/12/68 File Registration No. 848 Agency: _____
 Certified Cor. Record Prepared? Yes No Filed At: Umatilla Co. Courthouse Date 11/16/72

REMARKS