

Form 874-9—Revised May, 1918

U. S. DEPARTMENT OF AGRICULTURE
FOREST SERVICE

Umatilla NATIONAL FOREST

CORNERS OF THE PUBLIC SURVEY

T. 1 S R. 36 E W. Mer.

114 Corner common to Sections

21, and 28

Corner consists of a Stake not (not) in place

State condition found

Dimensions above ground _____ inches.

Sketch grooves, letters, figures, or notches, on proper face or edge.

CARDINAL POSITION

DIAGONAL POSITION

--	--	--	--

--	--	--	--

N W S E

NW SW SE NE

Mound of _____ is located _____

_____ Pits are located _____

Sketch markings of Bearing Trees (or Rocks) in proper box and fill blanks below, giving bearings from Corner to Trees and Distances in Links.

Species _____

Diameter _____

Bearing _____

Distance _____

Do you believe this to be a genuine Land Office Corner? Yes

If not, why? Two witnesses to mark

still standing, trees 19.7.

H. E. Vincent

Signature.

1918


Date.

2112

Title.

T. 1 S R. 36 E W Mer. ✓

8-3027 (Make sketch of topography near Corner.)

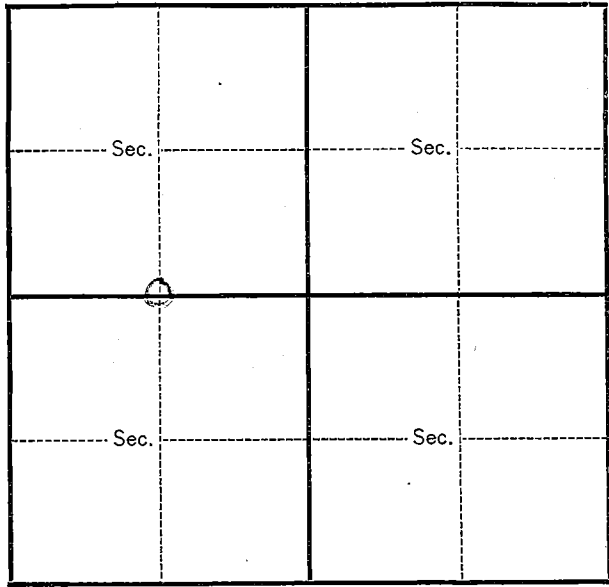

Metal Location Poster is on a _____
 tree _____ inches diameter, on the _____
 side of _____
 from which this Corner bears _____
 _____ chains distant.

Give any further facts which will aid in finding this
 Corner again.

*Location poster has been
 replaced that was the
 west.*
*It is in a scrubby
 stand of timber on north
 hillside*