

Form 874-9—Revised May, 1918

U. S. DEPARTMENT OF AGRICULTURE
FOREST SERVICE

Umatilla NATIONAL FOREST

CORNERS OF THE PUBLIC SURVEY

T. 18 R. R 22 Mer.

Section Corner common to Sections

26, 27, and 28

Corner consists of a stone ~~(not)~~ in place

State condition poor

Dimensions above ground _____ inches.

Sketch grooves, letters, figures, or notches, on proper face or edge.

CARDINAL POSITION

DIAGONAL POSITION

--	--	--	--

--	--	--	--

N W S E

NW SW SE NE

Mound of _____ is located _____

_____ Pits are located _____

Sketch markings of Bearing Trees (or Rocks) in proper box and fill blanks below, giving bearings from Corner to Trees and Distances in Links.

Species _____

Diameter _____

Bearing _____

Distance _____

Do you believe this to be a genuine Land Office Corner? Yes

If not, why? _____

H. S. Vincent
Signature


10/10/20
Date

S. S. S.
Title

T. 1 S R. 36 E Mer. V

8-3027

(Make sketch of topography near Corner.)

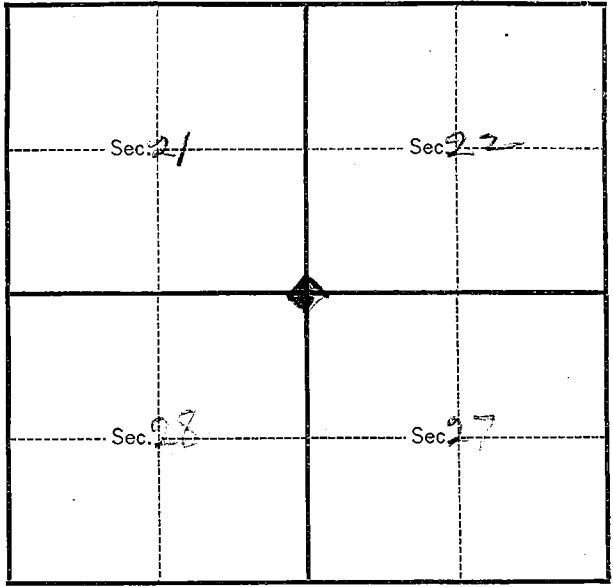

Metal Location Poster is on a _____
tree _____ inches diameter, on the _____
side of _____
from which this Corner bears _____
_____ chains distant.

Give any further facts which will aid in finding this
Corner again.

*found fresh blazes
assuming to be from the
same C*

Index
File No. R-13

CORNER RECORD (SEARCH)

(Ref. FSM 7151.4)

Tract or
Survey No. R 13

Cor.
No. 63
Sec


T 1 S R 36 E

R.D. Pendleton County Umatilla

Merid. Willamette

N.F. Umatilla State Oregon

CORNER DIAGRAM

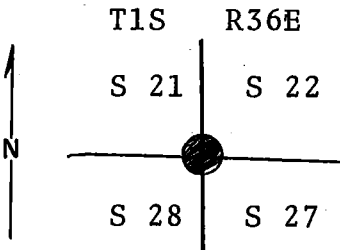

DESCRIBE CORNER MONUMENT FOUND

Brass cap set summer 1972. See reverse side.
Found original post rotted off 18" above the ground,
marked T1S S22 on NE face, R36E S27 on SE face &
S28 on SW face. NW face is rotted away.
Found a down and dead tamarack 12" diam. with scribing

DESCRIBE BEARING TREES OR OTHER OFFICIAL ACCESSORIES FOUND

visible, bearing N55°E 11 ft. dist. from the post.
Found a down and dead tamarack 10" diam. with scribing
visible, bearing S28°W 17.2 ft. dist. from the post.

PHOTO IDENTIFICATION DATA

Photo No. _____
Filed At. _____
Object Ident. _____
Ident. By _____
Signature

DESCRIBE CORNER LOCATION RELATIVE TO NEAR-BY FEATURES, ALSO HOW TO REACH CORNER

PLANE COORDINATE POSITION DATA

State _____ Zone _____
X _____
Y _____
Estab. By _____
Agency



Signature

Title

Division

Headquarters

Date

7100-52 (3/68)

4

5

CORNER RECORD (PERPETUATION)

MONUMENT: DESCRIBE NEW MONUMENT SET, OR WORK DONE TO PRESERVE EXISTING MONUMENT

At the location of the found post, set a 2½x30" iron pipe with 3" brass cap marked as shown for the corner to section 21, 22, 28, & 27, from which new BTs:

9

ACCESSORIES : DESCRIBE NEW BT'S WITNESS OBJECTS ETC. ESTABLISHED, OR WORK DONE TO PRESERVE EXISTING EVIDENCE

- A fir 16" dia. bears N37°E 18.3 ft. dist. marked T1S R36E S22 BT.
- A fir 25" dia. bears S75°E 14.4 ft. dist. marked T1S R36E S27 BT.
- A fir 12" dia. bears S54°W 19.3 ft. dist. marked T1S R36E S28 BT.
- A fir 7" dia. bears N25°W 17.7Ft. dist. marked "X" BT.

All distances taken to a brass washer in the blaze of each tree.
Set a steel fence post approx. 5 ft. NE from corner with "Attention" sign attached.

~~Used steel tape and magnetic compass with declination = 20° E.~~

10

Work Done By D.M. Ferguson Title Land Surveyor Date 7/12/69 State Registration No. 848
or Agency _____

Certified Cor. Record Prepared ? Yes No Filed At: Umatilla Co. Courthouse Date 11/16/72

11

REMARKS