


Index  
File No. R-25  
T 1 S R. 36E  
Merid. Willamette

**CORNER RECORD (SEARCH)**  
(Ref. FSM 7151.4)

R.D. Pendleton County Umatilla  
N.F. Umatilla State Oregon  
Tract or Survey No. R 25

Co. 65 Sec. 3  
No. 3

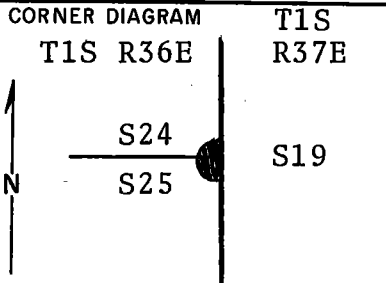

DESCRIBE CORNER MONUMENT FOUND Brass cap set summer 1972.  
Found a 40" pine, live in good condition, with all scribing visible, bearing N80°W, 40.3 ft. distant from the corner position.  
Found a 32" pine down and rotten; blaze and axe marks visible with scribing burnt out. Bearing S3°E 39.52

DESCRIBE BEARING TREES OR OTHER OFFICIAL ACCESSORIES FOUND  
ft. from the corner position.  
Found a 36 in. pine snag (dead) with all scribing visible. Bearin S40°W 71.2 ft. from corner position.

PHOTO IDENTIFICATION DATA  
Photo No. \_\_\_\_\_  
Filed At. \_\_\_\_\_  
Object Ident. \_\_\_\_\_  
Ident. By \_\_\_\_\_  
*Signature*

DESCRIBE CORNER LOCATION RELATIVE TO NEAR-BY FEATURES, ALSO HOW TO REACH CORNER  
Notes give 188 lks. distance; original surveyor apparently intended to give 108 lks distance.  
Compass bearing South intersects corner to Sec/ 19 & 30, T1S, R37E.

PLANE COORDINATE POSITION DATA  
State \_\_\_\_\_ Zone \_\_\_\_\_  
X \_\_\_\_\_  
Y \_\_\_\_\_  
Estab. By \_\_\_\_\_  
*Agency*



Signature \_\_\_\_\_ Title \_\_\_\_\_ Division \_\_\_\_\_ Headquarters \_\_\_\_\_ Date \_\_\_\_\_

CORNER RECORD (PERPETUATION)

MONUMENT: DESCRIBE NEW MONUMENT SET, OR WORK DONE TO PRESERVE EXISTING MONUMENT

Set a 30x2 1/2 in. iron pip with 3" brass cap marked as shown, 24" in the ground for the corner to Sec. 24 & 25, T1S, R36E. from which new BTs:

9

ACCESSORIES : DESCRIBE NEW BT'S WITNESS OBJECTS ETC. ESTABLISHED, OR WORK DONE TO PRESERVE EXISTING EVIDENCE

a fir 14" in diam. bears S56°E, 4.8 ft. dist. marked T1S, R37E, S19 BT.  
a tamarack 16 " in diam. bears S76°W 12.6 ft. dist. marked T1S, R36E, S25 BT. Distances taken to a brass washer in the blaze of each tree.  
Set a steel fence post approx. 5 ft. North from corner position with "Attention" sign attached.

Used steel tape and magnetic compass with declination = 20° East.

10

Work Done By D. M. Ferguson Title Land Surveyor Date 7/12/68 State Registration No. 848  
or Agency

Certified Cor. Record Prepared ? Yes No Filed At Umatilla Co. Courthouse Date 11/16/72

11

REMARKS

12

Index File No. T. R. M. Tract or Surv. No. Cor. 13