

CORNER RECORD (SEARCH)

(Ref. FSM 7151.4)

Tract or Survey No. _____


Cor. No. V-3 69

Index File No. V-3

T 1 S. R. 36 E. R.D. Pendleton County Umatilla

Merid. Willamette N.F. Umatilla State Oregon

CORNER DIAGRAM

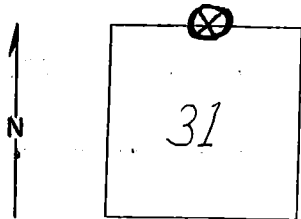

DESCRIBE CORNER MONUMENT FOUND

None found.

DESCRIBE BEARING TREES OR OTHER OFFICIAL ACCESSORIES FOUND

P. Pine BT, 17"DBH, N45°W, 27 lks, living, scribing visible.

No evidence of fir BT.

PHOTO IDENTIFICATION DATA 2-

Photo No. EQO(7/19/66)289

Filed At. _____

Object Ident. 10" pine

Ident. By Tom Sutherland

Signature

PLANE COORDINATE POSITION DATA

State _____ Zone _____

X _____

Y _____

Estab. By _____

Agency

DESCRIBE CORNER LOCATION RELATIVE TO NEAR-BY FEATURES, ALSO HOW TO REACH CORNER

Used topog. map to locate area of corner on aerial photo.
Drove to opening on ridge top above corner.
BT is located in a growth of young ponderosa pine, with



Signature

Ken Magoon

Title

Eng. Aid

Division

U.S.F.S.; Umatilla N.F.; S.O.

Headquarters

Date

17 Sept 1969

7100-52 (3/68)

CORNER RECORD (PERPETUATION)

MONUMENT: DESCRIBE NEW MONUMENT SET, OR WORK DONE TO PRESERVE EXISTING MONUMENT

ACCESSORIES : DESCRIBE NEW BT'S WITNESS OBJECTS ETC. ESTABLISHED, OR WORK DONE TO PRESERVE EXISTING EVIDENCE

Painted BT red,
Posted BT tag.
Posted attention sign on BT.

Work Done By Mike Lilly Title Eng. Aid Date 8/27/69 State Registration No. or Agency _____

Certified Cor. Record Prepared ? Yes No Filed At: _____ Date _____

REMARKS

Pin pricked 10" pine, S28°W, 134 lks. from pine BT.

Index File No. V-3 T. 1 S. R. 36 E. M. Willamette Tract or Surv. No. Cor, V-3