

Index


File No. X-25

CORNER RECORD (SEARCH)

(Ref. FSM 7151.4)

Tract or
Survey No. _____Cor.
No. _____T 1S R. 36E R.D. WALLA WALLA County UMATILLAMerid. WILLAMETTE N.F. UMATILLA State OREGON

CORNER DIAGRAM

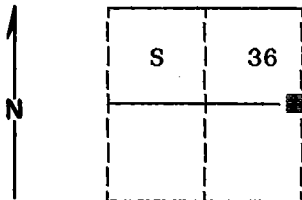

DESCRIBE CORNER MONUMENT FOUND

Found no evidence of the original corner monument

DESCRIBE BEARING TREES OR OTHER OFFICIAL ACCESSORIES FOUND

Found a 24 inch diameter Ponderosa Pine, S89°W,
10 lks, live and vigorous with blaze evident.

PHOTO IDENTIFICATION DATA

Photo No. 12 616140A 787-221Filed At. Ranger OfficeObject Ident. Bearing TreesIdent. By D.I. Griffith
signature

PLANE COORDINATE POSITION DATA

State _____ Zone _____

X _____

Y _____

Estab. By _____

Agency

Signature

Title
Surveyor

Division

Headquarters

Date
9-19-89

FS-7100-52 (3/68)

5

CORNER RECORD (PERPETUATION)

MONUMENT: DESCRIBE NEW MONUMENT SET, OR WORK DONE TO PRESERVE EXISTING MONUMENT

Set a 2½"x30" aluminum pipe with aluminum cap marked as shown:
 Pipe is set 27 inches in the ground.

T1S
 R36E R37E
 ¼ |
 | |
 S 36 |
 1989
 OPLS 644

Raised a small mound of stone around monument.

ACCESSORIES : DESCRIBE NEW BT'S WITNESS OBJECTS ETC. ESTABLISHED, OR WORK DONE TO PRESERVE EXISTING EVIDENCE

New Bearing Tree;

A 9 inch diameter Ponderosa Pine bears N16°W, 22.57 feet marked ¼ S36 BT

Painted a 6 inch red band around all bearing trees and attached 54-3 and 54-9 signs.

Set a steel fence post approximately 5 feet South with 54-9 sign attached.

Work Done By D. I. Griffith Title Surveyor Date 9-20-89 State Registration No. OPLS 644
 or Agency _____

Certified Cor. Record Prepared ? Yes No Filed At: Umatilla Co. Surveyor's Office Date 9-89

REMARKS

Witness: Rick Robinson

Index File No. X-25 T. 1S R. 36E W.M. Tract or Surv. No. Cor. 12
 13

USDA-FOREST SERVICE

Index
File No. X-25

CORNER RECORD (SEARCH)

(Ref. FSM 7151.4)

Tract or
Survey No. _____

Cor.
No. _____


T 1S R. 36E

R.D. WALLA WALLA County UMATILLA

Merid. WILL

N.F. UMATILLA State OREGON

CORNER DIAGRAM

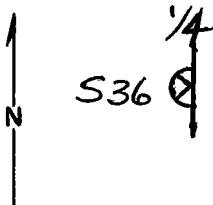

DESCRIBE CORNER MONUMENT FOUND

SCATTERED STONE MOUND AT CORNER.

DESCRIBE BEARING TREES OR OTHER OFFICIAL ACCESSORIES FOUND

ORIGINAL 18" PINE IS NOW 24" PONDEROSA PINE WITH A SINGLE HEALED BLAZE, BEARS S89°W, 6.6 ft. PUT BT SIGN ON FRONT & LSM SIGN ON BACK.

PHOTO IDENTIFICATION DATA

Photo No. _____

Filed At. _____

Object Ident. _____

Ident. By _____

Signature

PLANE COORDINATE POSITION DATA

State _____ Zone _____

X _____

Y _____

Estab. By _____

Agency

DESCRIBE CORNER LOCATION RELATIVE TO NEAR-BY FEATURES, ALSO HOW TO REACH CORNER

CORNER IS 330± FT SOUTH OF LOCATION POSTER I PLACED ON RIDGE TOP ON A 6" PONDEROSA PINE.

Signature

Title

Division

Headquarters

Date

FS-7100-52 (3/68)

Dennis L. Gaylord

LS 1636

S.O.

5-19-88

CORNER RECORD (PERPETUATION)

MONUMENT: DESCRIBE NEW MONUMENT SET, OR WORK DONE TO PRESERVE EXISTING MONUMENT

ACCESSORIES : DESCRIBE NEW BT's WITNESS OBJECTS ETC. ESTABLISHED, OR WORK DONE TO PRESERVE EXISTING EVIDENCE

Work Done By _____ Title _____ Date _____ State Registration No. or Agency _____

Certified Cor. Record Prepared ? Yes No Filed At: _____ Date _____

REMARKS

Index File No. T. R. M. Tract or Surv. No. Cor.