


CERTIFIED RECORD OF LAND CORNER MONUMENTATION

HISTORY OF ORIGINAL CORNER ESTABLISHMENT:

Corner originally established by John A. Hurlburt under GLO contract Number 201, dated August 5, 1873. Surveyor General record states:
Set pine post 5ft long 5in square 2ft in ground, from which;
A 12" Fir bears N64°W, 24 lks.
A 8" Pine bears S17°W, 21 lks.
A 8" Pine bears N23°E, 35 lks.
A 10" Pine bears S65°E, 14 lks.

Survey 11-82 calls blazing and scribing a 11" Tamarack as corner.

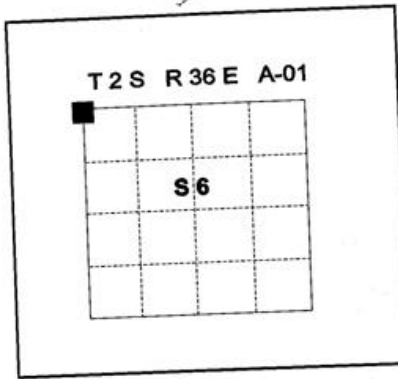

No record of subsequent monumentation found in Union County survey records

DESCRIPTION OF CORNER EVIDENCE FOUND:

Found 11" Tamarack blazed and scribed as per 11-82. Found 18" White Fir snag bearing S16°W, 19.65 feet blazed and scribed. Found 11" Tamarack bearing N66°W, 8.61 feet, blazed and scribed, alive and vigorous.
See Union County Survey Number 043-1995.

DESCRIPTION OF MONUMENT AND ACCESSORIES I ESTABLISHED TO PERPETUATE THE ORIGINAL LOCATION OF THIS CORNER:

NEW BEARING TREES:

- A 13" Tamarack bears N84°E, 33.40 feet, marked T1S R36E S31 BT.
- A 9" Lodgepole Pine bears South, 6.10 feet, marked T2S R36E S6 BT.
- A 14" Tamarack bears S74°W, 26.61 feet, marked T2S R35E S1 BT.

I hereby certify that the corner was monumented on October 9, 1995.
Witness: Mark Durbin, Jeff Madsen

REGISTERED
PROFESSIONAL
LAND SURVEYOR
Gregory T. Blackman
OREGON
JULY 12, 1972
GREGORY T. BLACKMAN
991

Renewal Date: December, 31 1995

I used a steel tape and magnetic compass in the establishment of the new accessories. I used 18° East declination, the distances are to a 60d spike driven into the right side of the root crown of the bearing tree.

RECEIVED BY
Umatilla County Surveyor
Date 12-95
Rec'd By KK
No. 95-212-C

A-01