


**CERTIFIED RECORD OF LAND CORNER MONUMENTATION**

**HISTORY OF ORIGINAL CORNER ESTABLISHMENT:**

Corner originally established by John A. Hurlburt under GLO Contract Number 201, dated August 5, 1873. Surveyor General record states:

T 1 S R 36 E Z-11

Set basalt stone 18x14x6-8 in. in ground for 1/4 Sec. Cor.

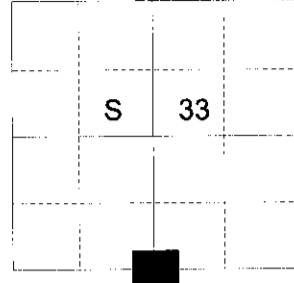

Union County monumentation record 173-87R is a Forest Service corner record. Record states: Stone 18"x14"x16"-8" above ground (2 P.P. stumps correctly located. 36" P.P. stump - poor cond. in sec 4. No scribing visible, only bottom of blaze remains.

**DESCRIPTION OF CORNER EVIDENCE FOUND:**

Found a basalt stone 18"x14"x6" lying flat on ground with a steel fence post with BLM K-tag along the East side, from which:  
A pine stump bears North 10° East, a distance of 14 feet.  
A pine stump bears South 28° East, a distance of 30 feet.

**DESCRIPTION OF MONUMENT AND ACCESSORIES I ESTABLISHED**

**TO PERPETUATE THE ORIGINAL LOCATION OF THIS CORNER:**

At the stone position, I set a 2 1/2" x 30" aluminum pipe with 2 1/2" aluminum cap, marked as shown below, 27 inches in the ground, with a mound of stone 2 feet diameter, from which:


- An 11 inch Douglas Fir bears North 27° East, a distance of 19.45 feet, marked 1/4 S33 BT.
- A 12 inch Ponderosa Pine bears South 46° East, a distance of 44.55 feet, marked 1/4 S4 BT.
- A 10 inch Ponderosa Pine bears South 23° West, a distance of 53.85 feet, marked 1/4 S4 BT.
- A 14 inch Ponderosa Pine bears North 46° West, a distance of 54.60 feet, marked 1/4 S33 BT.

Set steel fencepost 1 ft. East of corner monument.  
I hereby certify that the corner was perpetuated on October 30, 2012.

Witness: Rick Robinson



Renewal Date: June 30, 2013

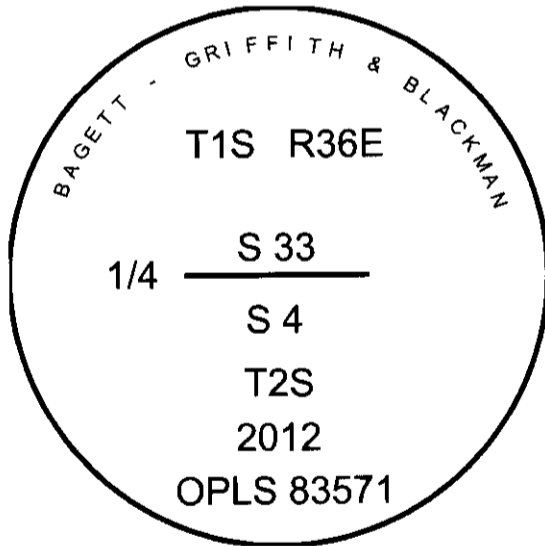

I used a steel tape and magnetic compass in the recovery of the bearing tree and establishment of new trees. I used 16° East magnetic declination and the bearings and distances are to the center of root crown on old bearing tree. Distance is to a 60d spike in the right hand side of the new trees. Bearing is to a brass washer marked OPLS 83571 in the lower BT blaze.

**RECEIVED BY**  
Umatilla County Surveyor  
Date: 12/14/2012  
Rec'd By: [Signature]  
No.: 12-144-B