

USDA-FOREST SERVICE

Index
File No. A-21
T 1S R. 37E
Merid. WILL


CORNER RECORD (SEARCH)

(Ref. FSM 7151.4)

Tract or
Survey No. _____ Cor. No. _____

R.D. WALLA WALLA County UMATILLA
N.F. UMATILLA State OREGON

CORNER DIAGRAM

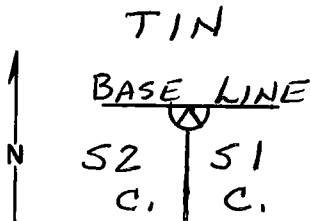

T1S R37E

DESCRIBE CORNER MONUMENT FOUND

NONE - CORNER STONE MAY BE COVERED BY A FALLEN TREE.

DESCRIBE BEARING TREES OR OTHER OFFICIAL ACCESSORIES FOUND

ORIGINAL 18" FIR IS A BADLY DECAYED BROKEN SNAG 5' HIGH. THERE IS HEALED SCARS ON THE BARK, BUT THE WOOD IS DECAYED SO NO SCRIBES REMAIN. LYING AT THE BASE OF THIS FIR SNAG IS A PINE SLAB WITH SCRIBES "R37E S35 BL" VISIBLE. FIR SNAG BEARS S89°30'W, 13.2ft.

DESCRIBE CORNER LOCATION RELATIVE TO NEAR-BY FEATURES, ALSO HOW TO REACH CORNER

I COULD NOT FIND ANY REMAINS OF THE RECORD 5" FIR OR ANY THING OF THE RECORD 20" PINE OTHER THAN THE SLAB LYING BY THE FIR SNAG B.T. I PLACED BT SIGNS ON FIR SNAG & PINE SLAB. I PLACED LOCATION POSTER ON 14" WHITE FIR 5ft. NORTH OF CORNER & 550ft EAST.

ON RIDGE TOP OF TRAIL

PHOTO IDENTIFICATION DATA

Photo No. _____
Filed At. _____
Object Ident. _____
Ident. By _____
Signature _____

PLANE COORDINATE POSITION DATA

State _____ Zone _____
X _____
Y _____
Estab. By _____
Agency _____

Signature

Title

Division

Headquarters

Date

FS-7100-52 (3/68)

Dennis L. Gaylord PLS 1636

J.O. 7-16-86

CORNER RECORD (PERPETUATION)

MONUMENT: DESCRIBE NEW MONUMENT SET, OR WORK DONE TO PRESERVE EXISTING MONUMENT

9

ACCESSORIES : DESCRIBE NEW BT's WITNESS OBJECTS ETC. ESTABLISHED, OR WORK DONE TO PRESERVE EXISTING EVIDENCE

10

Work Done By _____ Title _____ Date _____ State Registration No. or Agency _____

Certified Cor. Record Prepared ? Yes No Filed At: _____ Date _____

11

REMARKS

12

Index File No. T. R. M. Tract or Surv. No. Cor. 13