

USDA-FOREST SERVICE

Index
File No. F-1

CORNER RECORD (SEARCH)

(Ref. FSM 7151.4)

Tract or
Survey No. _____ Cor.
No. _____


T 1S R. 37E

R.D. Walla Walla County Umatilla

Merid. Willamette

N.F. Umatilla State Oregon

CORNER DIAGRAM

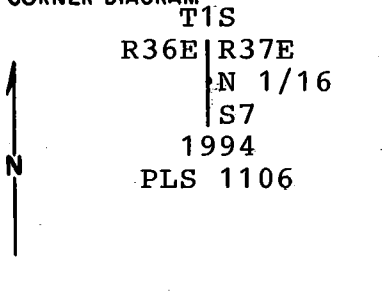

DESCRIBE CORNER MONUMENT FOUND

None. This corner was established as part of this survey.

DESCRIBE BEARING TREES OR OTHER OFFICIAL ACCESSORIES FOUND

None.

PHOTO IDENTIFICATION DATA

Photo No. _____
Filed At. _____
Object Ident. _____
Ident. By _____
Signature

DESCRIBE CORNER LOCATION RELATIVE TO NEAR-BY FEATURES, ALSO HOW TO REACH CORNER

Corner is on boulder strewn knob on southwesterly slope, at east edge of clearcut, midway from bench to top of Wilbur Mountain.

PLANE COORDINATE POSITION DATA

State _____ Zone _____
X _____
Y _____
Estab. By _____
Agency

Signature
Will. R. Wells

Title
PLS

Division

Headquarters
PENOLETON

Date
11/3/94

FS-7100-52 (3/68)

CORNER RECORD (PERPETUATION)

MONUMENT: DESCRIBE NEW MONUMENT SET, OR WORK DONE TO PRESERVE EXISTING MONUMENT

A 2 1/2" aluminum cap on a 2 1/2" x 30" aluminum pipe, 22 inches in the ground, with mound of stone to cap, marked as shown in diagram. Set a steel fence post with sign 54-2 and 54-9 attached, 3.8 feet North of monument.

ACCESSORIES : DESCRIBE NEW BT's WITNESS OBJECTS ETC. ESTABLISHED, OR WORK DONE TO PRESERVE EXISTING EVIDENCE

A 6" white fir bears N8°E-32.3 feet, scribed: N1/16 S7 BT.
A 15" tamarack bears S7 3/4°E-10.7 feet, scribed: N1/16 S7 BT.

Bearing trees have a brass washer stamped 'PLS 1106' nailed to the face of the blaze. Attached 54-3 and 54-9 signs, painted face of blaze red, and 6" red band around each bearing tree.

Work Done By WR Wells Title PLS Date _____ State Registration No. or Agency PLS 1106

Certified Cor. Record Prepared? Yes No _____ Filed At: UMATILLA COUNTY SURVEYOR'S OFFICE Date 12/94

REMARKS

This corner was monumented as part of a USFS contract.

Index File No. T. R. M. Tract or Surv. No. Cor. 12
13
F1 1S 37E Willamette