


Index
File No. J-1
T 15 R. 38E
Merid. Willamette

CORNER RECORD (SEARCH)
(Ref. FSM 7151.4)

Tract or
Survey No. _____
Cor. 12 | 7
No. 13 | 18

R.D. LaGrande County Union
N.F. W-W State Oregon

CORNER DIAGRAM

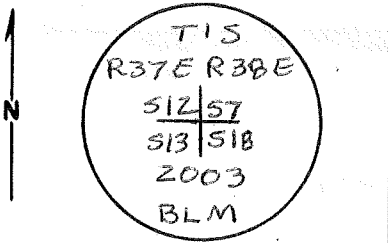

DESCRIBE CORNER MONUMENT FOUND

searched for nothing found

DESCRIBE BEARING TREES OR OTHER OFFICIAL ACCESSORIES FOUND

PHOTO IDENTIFICATION DATA

Photo No. _____
Filed At. _____
Object Ident. _____
Ident. By _____
Signature

DESCRIBE CORNER LOCATION RELATIVE TO NEAR-BY FEATURES, ALSO HOW TO REACH CORNER

Corner located S30°W, 100' from ravine
draining N50°W

PLANE COORDINATE POSITION DATA

State _____ Zone _____
X _____
Y _____
Estab. By _____
Agency

Signature Bryan Seibold Title Cad. Sur. Division BLM Headquarters Pendleton Date 2003

CORNER RECORD (PERPETUATION)

MONUMENT: DESCRIBE NEW MONUMENT SET, OR WORK DONE TO PRESERVE EXISTING MONUMENT

Set stainless steel post 28" long, 2 1/2" diam, 24" in the ground in stone mound with brass cap. Deposit white magnet at base of post.

ACCESSORIES : DESCRIBE NEW BT'S WITNESS OBJECTS ETC. ESTABLISHED, OR WORK DONE TO PRESERVE EXISTING EVIDENCE 9

12" Spruce bears N56 1/2° E, 26.9' scribed T15 R38E S7 BT

25" Spruce bears S27° E, 61.2' scribed T15 R38E S18 BT

14" Tamarack bears S73° W, 55.1' scribed T15 R37E S13 BT

18" Tamarack bears N45 1/4° W, 62.7' scribed T15 R37E S12 BT

Distance measured to 2 1/2" x 1/4" Mag Nail in right side center 10Work Done By B. Seibeld Title Cad. Surv. Date 2003 State Registration No. BLM
or AgencyCertified Cor. Record Prepared? Yes No Filed At:

Date

11

REMARKS

Index File No.

T.

R.

M.

Tract or Surv. No.

Cor.

1213

J-1

15 - 38E

Will.