

USDA-FOREST SERVICE

Index

File No. N-13

CORNER RECORD (SEARCH)

(Ref. FSM 7151.4)

Tract or

Survey No. _____ Cor. No. _____


T 1S R 37E

R.D. WALLA WALLA County UMATILLA

Merid. WILLAMETTE

N.F. UMATILLA State OREGON

CORNER DIAGRAM

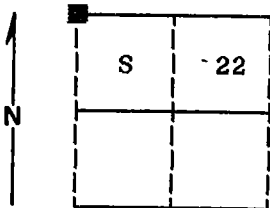

DESCRIBE CORNER MONUMENT FOUND

Found a stone 24x15x7 inches marked with 3 grooves South and East faces in a small mound of stone.

DESCRIBE BEARING TREES OR OTHER OFFICIAL ACCESSORIES FOUND

Found a 18 inch diameter Western Larch N82°E, 14 lks, dead and down with scribes visible.
 Found a root hole S42°E, 14 lks.
 Found the rotted remains of a Fir stump N4°W, 7 lks, with no marks visible.
 Found no evidence of the original Southwest BT.

PHOTO IDENTIFICATION DATA

Photo No. _____

Filed At. _____

Object Ident. _____

Ident. By _____

Signature

PLANE COORDINATE POSITION DATA

State _____ Zone _____

X _____

Y _____

Estab. By _____

Agency

Signature

Title

Division

Headquarters

Date

FS-7100-52 (3/68)

Surveyor

8-24-89

CORNER RECORD (PERPETUATION)

MONUMENT: DESCRIBE NEW MONUMENT SET, OR WORK DONE TO PRESERVE EXISTING MONUMENT

Set a 2½"x30" aluminum pipe with aluminum cap marked as shown:
Pipe is set 26 inches in the ground.

T1S	R37E
S 16	S 15
S 21	S 22
1989	
OPLS 644	

Raised mound of stone around monument, 2 ft. base to top of cap
Buried the original corner stone West and alongside of monument

ACCESSORIES: DESCRIBE NEW BTs WITNESS OBJECTS ETC. ESTABLISHED, OR WORK DONE TO PRESERVE EXISTING EVIDENCE

New BTs:

- A 14 inch diameter Douglas Fir bears N77°E, 23.34 feet marked T1S R37E S15 BT
- A 12 inch diameter Western Larch bears S47°E, 42.22 feet marked T1S R37E S22 BT
- A 12 inch diameter Douglas Fir bears S63°W, 38.89 feet marked T1S R37E S21 BT
- A 13 inch diameter White Fir bears N37°W, 21.30 feet marked T1S R37E S16 BT
- Painted a 6 inch red band around all bearing trees and attached 54-3 and 54-9 signs.

Set a steel fence post approximately 5 feet North with 54-9 sign attached.

Work Done By D. I. Griffith Title Surveyor Date 8-2-89 State Registration No. OPLS 644
or Agency

Certified Cor. Record Prepared? Yes No Filed At: Umatilla Co. Surveyor's Office Date 9-89

REMARKS

Witness: Rick Robinson

Index File No. N-13 T. 1S R. 37E W.M. Tract or Surv. No.

Cor.

USDA-FOREST SERVICE

Index
File No. N-13


CORNER RECORD (SEARCH)
(Ref. FSM 7151.4)

Tract or Survey No. _____
Cor. No. N-13

T 1S R. 37E
Merid. Willamette

R.D. Pendleton County Umatilla
N.F. Umatilla State Oregon

CORNER DIAGRAM

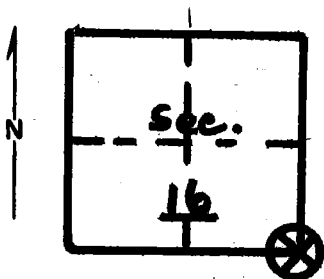

DESCRIBE CORNER MONUMENT FOUND

Material: Basalt Stone Size: 18"x12x6
Height Above Ground: 6" Condition: Fair
Markings: 3 notches on south edge.

DESCRIBE BEARING TREES OR OTHER OFFICIAL ACCESSORIES FOUND

15" down, rotten, Tam. - N82E - 9' dist. Tree has part of blaze with visible scribe marks on upper portion. Part of B scribed lower portion. S26E - 10' from stone is 24" fir blazed on 4 sides. I placed a location poster on north side.

Stump holes fit where other bearing trees would be.

DESCRIBE CORNER LOCATION RELATIVE TO NEAR-BY FEATURES, ALSO HOW TO REACH CORNER

PHOTO IDENTIFICATION DATA

Photo No. _____
Filed At. _____
Object Ident. _____
Ident. By _____
Signature

PLANE COORDINATE POSITION DATA

State _____ Zone _____
X _____
Y _____
Estab. By _____
Agency

Signature
Bill Moore

Title
Eng. Tech.

Division _____

Headquarters _____

Date
6/77

7100-52-(3/68)

CORNER RECORD (PERPETUATION)

MONUMENT: DESCRIBE NEW MONUMENT SET, OR WORK DONE TO PRESERVE EXISTING MONUMENT

9

ACCESSORIES : DESCRIBE NEW BT'S WITNESS OBJECTS ETC. ESTABLISHED, OR WORK DONE TO PRESERVE EXISTING EVIDENCE

I placed blank bearing tree poster on the down B.T.

10

Work Done By _____ Title _____ Date _____ State Registration No. or Agency _____

Certified Cor. Record Prepared ? Yes No Filed At: _____ Date _____

REMARKS

12

Index File No. T. R. M. Tract or Surv. No. Cor. 13