

Form 874-9

U. S. DEPARTMENT OF AGRICULTURE
FOREST SERVICE

Umatilla NATIONAL FOREST

CORNERS OF THE PUBLIC SURVEY



T. 18 R. 27^E Will Mer.

1/4 Corner common to Sections
30 31 and —

DESCRIPTION OF CORNER

Corner consists of a Rock

Dimension above ground — inches.
Sketch grooves, letters, figures, or notches, on proper face or edge.

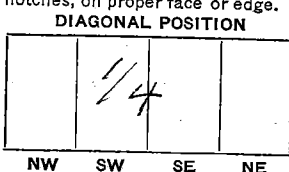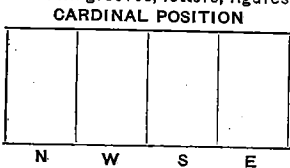

Mound of — is located —

Pits are located —

Sketch markings of Bearing Trees (or Rocks) in proper box and fill blanks below, giving bearings from Corner to Trees and Distances in Links.



Species	<u>Y.P.</u>	<u>Y.P.</u>	<u>Y.P.</u>	
Diameter	<u>12"</u>	<u>40"</u>	<u>28"</u>	
Bearing	<u>S</u>	<u>S</u>	<u>S.W.</u>	
Distance	<u>Down</u>	<u>Down</u>	<u>40</u>	

Do you believe this to be a genuine Land Office Corner? —

If not, why? —

Marked new tree

J. W. Pembert

Signature

Forest Ranger

Date

Title

S-3027


T. 15

R. 37

Mer. ✓

8-3027

(Make sketch of topography near Corner.)

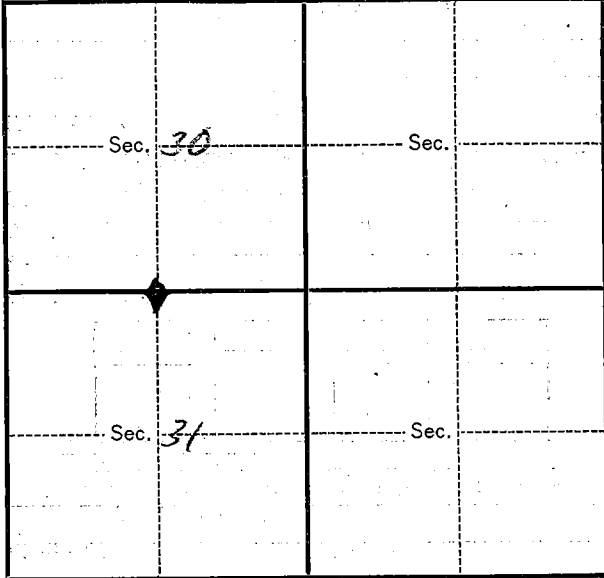

Metal Location Poster is on a Y.P.
 tree 4 1/2 inches diameter, on the west
 side of corner
 from which this Corner bears E
4 chains distant.

Give any further facts which will aid in finding this
 Corner again.

4 1/2 chains east of
road where road crosses
boundary line.

Form 874-9—Revised May, 1918

U. S. DEPARTMENT OF AGRICULTURE
FOREST SERVICE

Umatilla NATIONAL FOREST

CORNERS OF THE PUBLIC SURVEY

T. 1A R. 37E N Mer.

1/4 Corner common to Sections
30, and 31

Corner consists of a Mound of rock (not) in place
State condition Good

Dimensions above ground 8 inches.
Sketch grooves, letters, figures, or notches, on proper face or edge.

CARDINAL POSITION

DIAGONAL POSITION

N	W	S	E

NW	SW	SE	NE

Mound of _____ is located _____

Pits are located _____

Sketch markings of Bearing Trees (or Rocks) in proper box
and fill blanks below, giving bearings from Corner to Trees
and Distances in Links.

	<u>1/4</u>		
	<u>S</u>		

Species _____
Diameter 4 P
2.6"
Bearing S68W
Distance 24 ft

Do you believe this to be a genuine Land Office Corner? Yes
If not, why? _____


J D Monroe
Signature

July 22, 29
Date

T. 12 R. 37N Mer.

8-3027

(Make sketch of topography near Corner.)

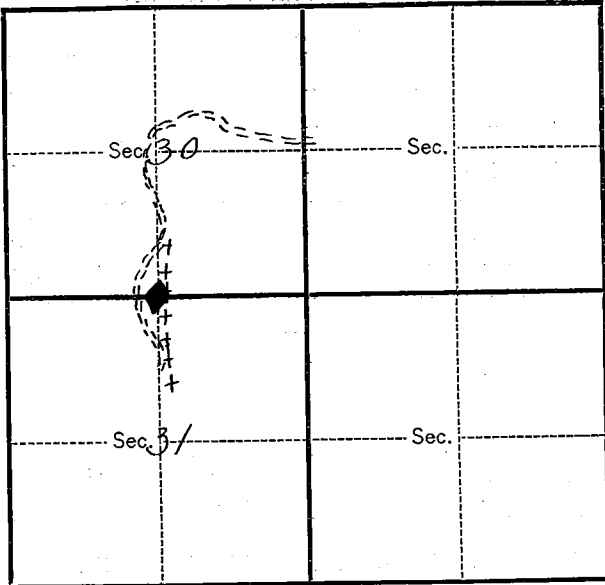

Metal Location Poster is on a 2P
tree 18 inches diameter, on the SE
side of the tree
from which this Corner bears N 56 E
35 lbs chains distant.

Give any further facts which will aid in finding this
Corner again.

An old logging railroad
right of way runs
420 lbs east of corner.
An old road runs
5 chains west of corner
on which a lumber
tag has been placed

Form 874-9—Revised May, 1918

U. S. Department of Agriculture

FOREST SERVICE

Wynantia NATIONAL FOREST

CORNERS OF THE PUBLIC SURVEY

T. *15* R. *37E* Mer. *W*

14 Corner common to Sections

30 and *31*
Corner consists of a *pile of rocks & stone* (not) in place



State condition *each in good condition*

Dimensions above ground *6"* inches.

Sketch grooves, letters, figures, or notches, on proper face or edge.

CARDINAL POSITION


DIAGONAL POSITION

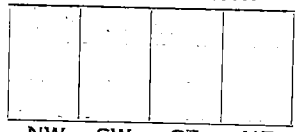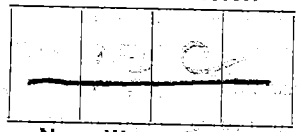

Mound of *rocks* is located

Pits are located

Sketch markings of Bearing Trees (or Rocks) in proper box and fill blanks below, giving bearings from Corner to Trees and Distances in Links.

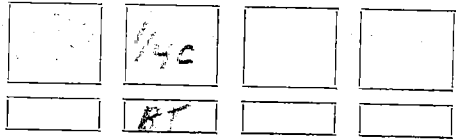

Species *K.P.*
 Diameter *30"*
 Bearing *S. 27° W*
 Distance *14'*

Do you believe this to be a genuine Land Office Corner? *Yes*


If not, why?

V. O. ...
(Signature)

...
(Date) (Title)

T. 15 R. 27 Mer.

(Make sketch of topography near Corner)

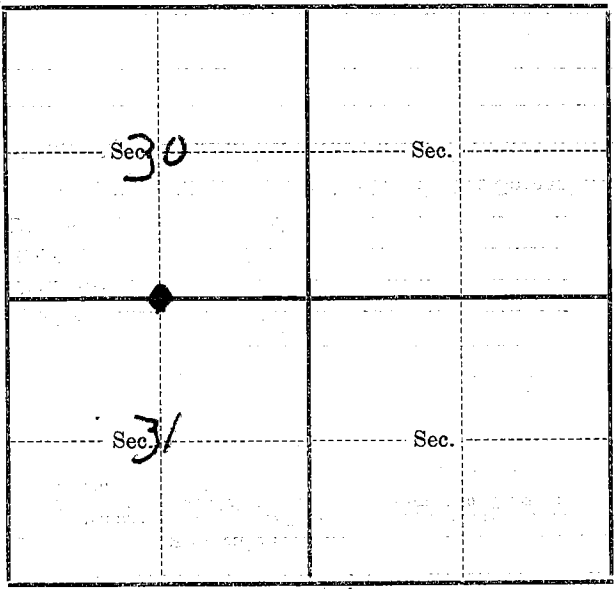

Metal Location Poster is on a Y.P. tree
tree 17 inches diameter, on the SE
side of line
from which this Corner bears S 57 E
18 1/2 chains distant.

Give any further facts which will aid in finding this
Corner again.


Corner 20 ft W of Haystack
and about 30 chains S of old
camp 3

LAND CORNER RECORD

LL 5680-2

1. T. 15 R. 37E No. 3 Cor. 1/4 Mer. Will. State Oregon (Rectangular) N. F. Umatilla Dist. Pendleton 10

2. Corner Status

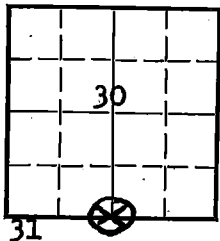

3. Original Description Resurvey vol. 279 Page 379 Where Recorded date 1882

4. Description of Corners: Page is missing from our GLO notes.

5. Investigation Notes: No stone or post found.

Bearing Trees:

30" P. Pine marked 1/4 S. bears S 37° W, 28 links

Corner is now marked, approximately, with a stake and a mound of rocks.

7. Photo Identification

Photo No. DVD 2M-20

Ident. By: _____

8. Plane Coordinate Position Data

State _____ Zone _____

X _____

Y _____

Estab. By _____

Field Book No. _____

Where Filed _____

9. Evaluation

Authentic _____

Needs Verif. Monument No

Re-estab. Survey _____

Land Status _____

6. Signed D. Finley Title Sur. Tech.

Date 10-21-64

PERPETUATION RECORD

10. Monument:

11. Accessories

Field Book _____ Page _____

12. Set By _____ Title _____

License _____ Agency _____ Date _____

13. Recorded By _____ Volume _____ Page _____

(Agency)

(Date) (City) (County) (State)

14. Remarks:

V-3

USDA-FOREST SERVICE

Index
File No. V-3

CORNER RECORD (SEARCH)


(Ref. FSM 7151.4)

Tract or
Survey No. _____ Cor.
No. _____

T 1 S R. 37E R.D. Pendleton County Umatilla

Merid. Will. N.F. Umatilla State Oregon

CORNER DIAGRAM

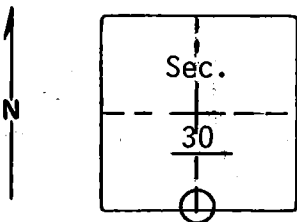

DESCRIBE CORNER MONUMENT FOUND

None

DESCRIBE BEARING TREES OR OTHER OFFICIAL ACCESSORIES FOUND

None. There is a 30" p. pine at approx. corner location. It has an X, a very old unreadable location poster, and 2 or 3 blazes on the west side. Also an X on the south side and an old blaze on the east side. There were old forest boundary posters on the east-west line. There is no evidence of original B.T.'s.

PHOTO IDENTIFICATION DATA

Photo No. _____

Filed At. _____

Object Ident. _____

Ident. By _____

Signature

PLANE COORDINATE POSITION DATA

State _____ Zone _____

X _____

Y _____

Estab. By _____

Agency

DESCRIBE CORNER LOCATION RELATIVE TO NEAR-BY FEATURES, ALSO HOW TO REACH CORNER

Tree described in block #3 is approx. 200 feet west of junction of Summit road and Spring Mtn. road.

Signature

J. Hollaman

Title

Division

Headquarters

Date

6-6-77

7100-52-(3/68)

CORNER RECORD (PERPETUATION)

MONUMENT: DESCRIBE NEW MONUMENT SET, OR WORK DONE TO PRESERVE EXISTING MONUMENT

ACCESSORIES: DESCRIBE NEW BT'S WITNESS OBJECTS ETC. ESTABLISHED, OR WORK DONE TO PRESERVE EXISTING EVIDENCE

This is no longer the Forest boundary since the F.S. acquired section 31. Therefore, I removed the Forest boundary posters and delivered them to the District Engineer.

Work Done By _____ Title _____ Date _____ State Registration No. or Agency _____

Certified Cor. Record Prepared? Yes No Filed At: _____ Date _____

REMARKS


Index File No. T. R. M. Tract or Surv. No. Cor. 12 13

LAND CORNER RECORD

(Rectangular)

1. $\frac{1}{4}$ S R 37E No. V3 Cor. $\frac{1}{4}$ Mer. Will State Ore N. F. Umatilla Dist. Pend

2. Corner Status

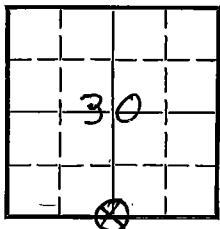

3. Original Description _____ Vol. _____ Page _____ Where Recorded BLM Portland

4. Description of Corners: Basalt stone 18"x9"x6" 12" in ground marked $\frac{1}{4}$ on N face from which a pine 48" dia bears S37°W 28 lks marked $\frac{1}{4}$ S B. T. a pine 12" dia bears N4°E 5 lks marked $\frac{1}{4}$ S B. T.

5. Investigation Notes:

24" dia pine brg. tree, blaze facing NE marked $\frac{1}{4}$ S B. T. found from us location poster on Summit Rd.

7. Photo Identification

Photo No. _____

Ident. By: _____

8. Plane Coordinate Position Data

State _____ Zone _____

X _____

Y _____

Estab. By _____

Field Book No. _____

Where Filed _____

9. Evaluation

Authentic _____

Needs Verif. Monument no

Re-estab. _____ Survey

Land Status U. S.

6. Signed R. C. Holmes Title Engineering Asst. Date 7-24-62

PERPETUATION RECORD

10. Monument:

11. Accessories

Field Book _____ Page _____

12. Set By _____ Title _____

License _____ Agency _____ Date _____

13. Recorded By _____ Volume _____ Page _____
(Agency)

(Date) (City) (County) (State)

14. Remarks:

V-3