

Index
File No. Z-03

CORNER RECORD (SEARCH)

(Ref. FSM 7151.4)

Tract or Survey No. _____ Cor. No. _____


T 1S R. 37E

R.D. WALLA WALLA County UMATILLA

Merid. WILLAMETTE

N.F. UMATILLA State OREGON

CORNER DIAGRAM

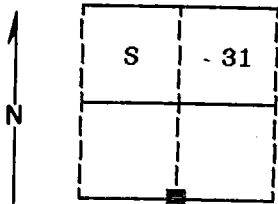

DESCRIBE CORNER MONUMENT FOUND

Found mound of stone at N15°W, 33 feet from bearing tree described below.
(Record S54°W 139 lks from corner to BT)

DESCRIBE BEARING TREES OR OTHER OFFICIAL ACCESSORIES FOUND

Found a 22 inch diameter Ponderosa Pine with 1/8 S scribes visible.
Tree faces N10°-20°E.

DESCRIBE CORNER LOCATION RELATIVE TO NEAR-BY FEATURES, ALSO HOW TO REACH CORNER

Corner falls on South side of open ridge approximately 200 feet South of the 31 road.

PHOTO IDENTIFICATION DATA

Photo No. _____

Filed At. _____

Object Ident. _____

Ident. By _____

Signature

PLANE COORDINATE POSITION DATA

State _____ Zone _____

X _____

Y _____

Estab. By _____

Aggley
Signature

Title

Surveyor

Division

Headquarters

Date

8-24-89

FS-7100-52 (3/68)

CORNER RECORD (PERPETUATION)

MONUMENT: DESCRIBE NEW MONUMENT SET, OR WORK DONE TO PRESERVE EXISTING MONUMENT

Did not monument corner due to the discrepancy between the record GLO information and the evidence in the field. I feel this problem will have to be solved with benefit of survey.

ACCESSORIES : DESCRIBE NEW BT's WITNESS OBJECTS ETC. ESTABLISHED, OR WORK DONE TO PRESERVE EXISTING EVIDENCE

None

Work Done By D. I. Griffith Title Surveyor Date 8-2-89 State Registration No. OPLS 644
or Agency

Certified Cor. Record Prepared ? Yes No Filed At: _____ Date _____

REMARKS

Witness: Rick Robinson

Index File No. Z-3 T. 1S R. 37E W.M. Tract or Surv. No. _____ Cor. _____

USDA-FOREST SERVICE

Index File No. Z-3

CORNER RECORD (SEARCH)

(Ref. FSM 7151.4)

Tract or Survey No. _____

Cor. No. _____


T 15 R. 37E

R.D. WALLA WALLA County UMATILLA

Merid. WILL

N.F. UMATILLA State OREGON

CORNER DIAGRAM

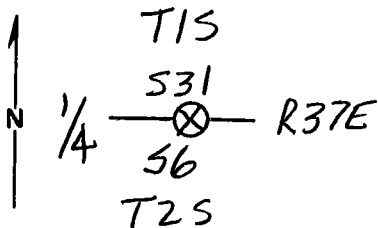

DESCRIBE CORNER MONUMENT FOUND

MOUND OF STONES 3' BASE x 6" HIGH

DESCRIBE BEARING TREES OR OTHER OFFICIAL ACCESSORIES FOUND

ORIG. 20" PONDEROSA PINE IS NOW 24" & THE UPPER BLAZE HAS BEEN CHOPPED OPEN TO REVEAL SCRIBES "1/4 S", LOWER BLAZE IS HEALED OVER. THIS TREE DOES NOT FIT RECORD. IT BEARS ABOUT S15°E, 33 FEET FROM THE MDS, WHICH IT FACES.

PHOTO IDENTIFICATION DATA

Photo No. _____
Filed At. _____
Object Ident. _____
Ident. By _____
Signature

DESCRIBE CORNER LOCATION RELATIVE TO NEAR-BY FEATURES, ALSO HOW TO REACH CORNER

CORNER IS ABOUT 200 FT. SOUTH OF RD 31, I PUT 54-3 & 54-4 SIGNS ON THE BT & A LOCATION POSTER ON A 18" POND. PINE 30 FT. SOUTH OF ROAD 31 & 200 FT. NORTH OF THE CORNER

PLANE COORDINATE POSITION DATA

State _____ Zone _____
X _____
Y _____
Estab. By _____
Agency

Signature Pennis J. Layland

Title

Division

Headquarters

Date

L.S. 1636

6-8-1988

FS-7100-52 (3/68)

CORNER RECORD (PERPETUATION)

MONUMENT : DESCRIBE NEW MONUMENT SET, OR WORK DONE TO PRESERVE EXISTING MONUMENT

9

ACCESSORIES : DESCRIBE NEW BT's WITNESS OBJECTS ETC. ESTABLISHED, OR WORK DONE TO PRESERVE EXISTING EVIDENCE

10

Work Done By _____ Title _____ Date _____ State Registration No. or Agency _____

Certified Cor. Record Prepared ? Yes No Filed At: _____ Date _____

11

REMARKS

12

Index File No. T. R. M. Tract or Surv. No. Cor. _____

13