

# OREGON CORNER RESTORATION FORM

COUNTY: Umatilla. DATE: 04/21/17.

CORNER DESIGNATION: C-1, The West one-quarter corner of Section 6, Township 2 North, Range 28 East, W.M..

PREVIOUS RENEWALS/SURVEYS ETC: Corner originally established by David P. Thompson Contract No. 83 dated July 22, 1859. Notes state: Set post corner for 1/4 Sec. corner in mound of earth & as per instructions. The corner point may have been computed by John Kimbrell, Deputy County Surveyor, in Survey No. 357, recorded at Record of Private Survey Book 2, Page 216, in December, 1912. Kimbrell's notes do not reveal anything set at the corner point. The position for this corner was computed by Steve Haddock in his Survey No. 13-555-C in 2013.

MONUMENT AND ACCESSORIES FOUND: None. Reestablished corner point at proportional position reported on Survey No. 13-555-C.

### MONUMENT MARKING DETAIL:

T2N  
R27E R28E  
1/4  
S1 | S6  
2017  
PLS 1106

MONUMENT SET: At the reestablished corner point, set a 1 1/4" by 30" galv. iron pipe with 2 3/8" brass cap 30" in the ground. Cap is marked as shown in "Monument Marking Detail".

### New accessories:

- A silver "Deep 1" magnet bears N 59° E, 27.8 feet.
- A pink "Deep 1" magnet bears S 39° E, 21.8 feet.
- A blue "Deep 1" magnet bears S 48° W, 22.5 feet.
- A orange "Deep 1" magnet bears N 17° W, 22.9 feet.

The Deep 1 magnets are buried 20" below ground line and have "bearing object" signs placed just above them. Set steel fence post 1 1/2 feet South of corner with "witness" sign wired to it.


LOCATION AND COMMENTS: Corner falls in a cultivated field.

FIRM: Wells Surveying  
P.O. Box 1696  
Pendleton, OR 97801

COMPASS DECLINATION: 18° East

\2N28C1

Surveyor's Seal

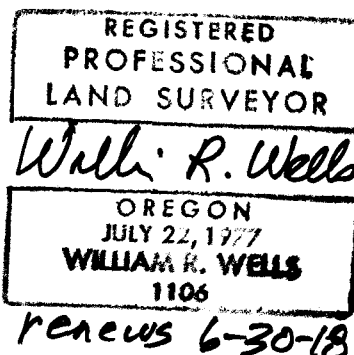

17-065-C