

# OREGON CORNER RESTORATION FORM

COUNTY: Umatilla. DATE: 04/17/17.

CORNER DESIGNATION: C-5, The East one-quarter corner of Section 6, Township 2 North, Range 28 East, W.M..

PREVIOUS RENEWALS/SURVEYS ETC: Corner originally established by David P. Thompson Contract No. 83 dated July 22, 1859. Notes state: Set post corner for 1/4 Sec. corner in mound of earth & as per instructions. The corner point was reestablished by John Kimbrell, Deputy County Surveyor, in Survey No. 357, recorded at Record of Private Survey Book 2, Page 216, in December, 1912. Kimbrell reports setting a marked square wood post 18" in the ground at the corner point.

MONUMENT AND ACCESSORIES FOUND: Found a 3 1/2 foot long section of 1 1/2" pipe set 2' in the ground with a 3 1/2 foot long section of 1 1/4" pipe welded to it.

## MONUMENT MARKING DETAIL:

T2N R28E  
1/4  
S6 | S5  
2017  
PLS 1106

MONUMENT SET: At the position of the found 1 1/2" iron pipe, set a 1 1/4 by 30" galv. iron pipe with 2 3/8" brass cap 30" in the ground. Placed the welded pipe near the corner monument on the South side. Cap is marked as shown in "Monument Marking Detail".

## New accessories:

- A 5/8" by 24" rebar with 1 1/4" red plastic cap bears N 46° E, 27.4 feet.
- A 5/8" by 24" rebar with 1 1/4" red plastic cap bears S 42° E, 29.9 feet.
- A 5/8" by 24" rebar with 1 1/4" red plastic cap bears S 39° W, 42.6 feet.
- A 5/8" by 24" rebar with 1 1/4" red plastic cap bears N 35° W, 32.6 feet.


The red plastic caps are marked "ORPLS 1106 WAPLS 17372". All rebar accessories have "bearing object" signs wired to them. Set steel fence post 2 1/2 feet South of corner with "witness" sign wired to it.

LOCATION AND COMMENTS: Corner fall in a sandy, unfarmed area between fields. There is a scoured drainage located about 25 feet East of the corner monument.

FIRM: Wells Surveying  
P.O. Box 1696  
Pendleton, OR 97801

COMPASS DECLINATION: 18° East

\2N28C5

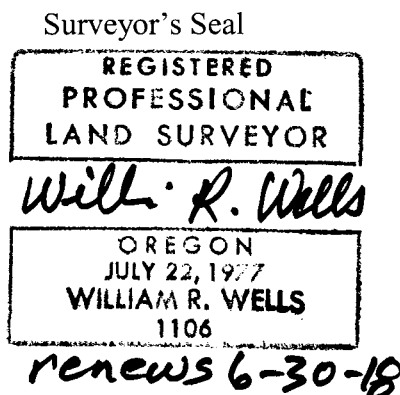

17-065-C