

OREGON CORNER RESTORATION FORM

COUNTY: Umatilla. DATE: 04/17/17.

CORNER DESIGNATION: E-9, The Northeast corner of Section 8, Township 2 North, Range 28 East, W.M.

PREVIOUS RENEWALS/SURVEYS ETC: Corner originally established by David P. Thompson Contract No. 83 dated July 22, 1859. Notes state: Set post corner for corner to Secs. 4, 5, 8 & 9 in mound of earth & as per instructions. The corner was recovered by John Kimbrell, Deputy County Surveyor, in Survey No. 357, recorded at Record of Private Survey Book 2, Page 216, in December, 1912. Kimbrell reports setting a marked square wood post 18" in the ground at the corner point.

MONUMENT AND ACCESSORIES FOUND: Found a 12" spike buried 12" below ground line at projection of old fences from the East and South, and held as best remaining evidence of the original corner location.

MONUMENT MARKING DETAIL:

T2N R28E
S5 | S4

S8 | S9
2017
PLS 1106

MONUMENT SET: A position of found 12" spike, set a 1 1/4 by 30" galv. iron pipe with 2 3/8" brass cap 27" in the ground in a 2 1/2" diameter earth mound. Placed 2, 6" granite stones in the mound beside the corner monument. Hit rotted wood fence post remains, 2' below ground line. Cap is marked as shown in "Monument Marking Detail".

New accessories:

A 3/4" brass washer marked "PLS 1106" nailed to the North side of a wood fence post bears S 62° E, 5.9 feet.

A 3/4" brass washer marked "PLS 1106" nailed to the West side of a wood fence post bears S 01° W, 11.5 feet..

A 5/8" by 24" rebar with 1 1/4" red plastic cap bears S 01° W, 25.3 feet.

A 5/8" by 24" rebar with 1 1/4" red plastic cap bears S 86° East, 17.0 feet.

The red plastic caps are marked "ORPLS 1106 WAPLS 17372". All rebar accessories are set in the existing fence lines and have "bearing object" signs wired to them. Nailed a "bearing object" sign to the wood fence posts with the brass washers. Nailed a "Witness" sign to a wood fence 5 feet South of corner monument.


LOCATION AND COMMENTS: Corner is located at projected fence intersection of fences extending East and South. Eagle Ranch County Road, a 16 foot dirt track is about 20 feet North of corner monument.

FIRM: Wells Surveying
P.O. Box 1696
Pendleton, OR 97801


COMPASS DECLINATION: 18° East

\2N28E9

Surveyor's Seal

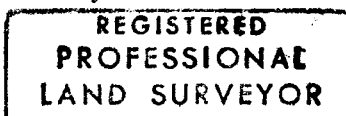

William R. Wells

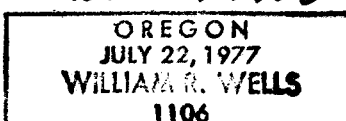

renews 6-30-18

17-065-C