

OREGON CORNER RESTORATION FORM

COUNTY: Umatilla. DATE: 04/27/17.

CORNER DESIGNATION: G-1, The West one-quarter of corner of Section 7, Township 2 North, Range 28 East, W.M..

PREVIOUS RENEWALS/SURVEYS ETC: Corner originally established by David P. Thompson Contract No. 83 dated July 22, 1859. Notes state: Set post corner for 1/4 Sec. corner in mound of earth & as per instructions. This corner point was likely computed by Deputy Surveyor John Kimbrell in his Survey No. 357 in December, 1912. Dave Krumbein computed a position for this corner in his Survey No. L-42-A.

MONUMENT AND ACCESSORIES FOUND: None. Corner was reestablished by single proportionate measurement between the reestablished Northwest corner of Section 7 and computed position for the Southwest corner of said Section 7. Posts of an ancient fence line extending North and South of the corner point was held for departure.

MONUMENT MARKING DETAIL:

T2N
R27E R28E
1/4
S12 | S7
2017
PLS 1106

MONUMENT SET: A the reestablished corner position, set a 1 1/4" by 30" galv. iron pipe with 2 3/8" brass cap 29" in the ground. Placed a three stones beside the corner monument. Cap is marked as shown in Monument Marking Detail.

New accessories:

A silver "Deep 1" magnet bears N 49° E, 23.8 feet.

A blue "Deep 1" magnet bears S 57° W, 22.2 feet.

A orange "Deep 1" magnet bears N 42° W, 25.7 feet.

A 5/8" by 24" rebar with 1 1/4" red plastic cap bears North 129.2 feet. Set North of North edge of active wheat field.

The red plastic cap is marked "ORPLS 1106 WAPLS 17372". Rebar accessory has a "bearing object" sign wired to it. "Deep 1" magnets are set 20" in the ground with "bearing object" signs placed just above them.. Set steel fence post 1 1/2 feet South of corner monument with "witness" sign wired to it.


LOCATION AND COMMENTS: Corner is located in an active wheat field about 120 feet South of a corner in the field.

FIRM: Wells Surveying
P.O. Box 1696
Pendleton, OR 97801


COMPASS DECLINATION: 18° East

\2N28G1

Surveyor's Seal

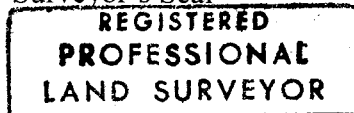

William R. Wells

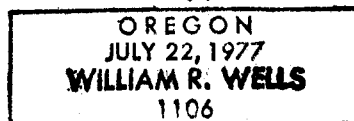

renews 6-30-18

17-065-C