

OREGON CORNER RESTORATION FORM

COUNTY: Umatilla. DATE: 04/22/17.

CORNER DESIGNATION: J-5, The Southwest corner of Section 7, Township 2 North, Range 28 East, W.M..

PREVIOUS RENEWALS/SURVEYS ETC: Corner originally established by David P. Thompson Contract No. 83 dated July 22, 1859. Notes state: Set post corner for corner to Secs. 7, 8, 17 & 18 in mound of earth & as per instructions. The corner point was reestablished by John Kimbrell, Deputy County Surveyor, in Survey No. 357, recorded at Record of Private Survey Book 2, Page 216, in December, 1912. Kimbrell reports setting a marked square wood post 18" in the ground at the corner point.

MONUMENT AND ACCESSORIES FOUND: None. Reestablished corner position by double proportionate measurement using the Thompson/Kimbrell record.

MONUMENT MARKING DETAIL:

T2N R28E
S7 | S8

S18 | S17
2017
PLS 1106

MONUMENT SET: At the reestablished corner position, set a 1 1/4 by 30" galv. iron pipe with 2 3/8" brass cap 36" in the ground. Cap is marked as shown in "Monument Marking Detail". This monument falls in the center of a farm road running North-South.

New accessories:

- A 5/8" by 24" rebar with 1 1/4" red plastic cap bears N 37°E, 20.3 feet.
- A 5/8" by 24" rebar with 1 1/4" red plastic cap bears S 34° W, 21.8 feet.
- A 5/8" by 24" rebar with 1 1/4" red plastic cap bears West 8.5 feet.
- A 5/8" by 24" rebar with 1 1/4" red plastic cap bears N 20° W, 21.6 feet.

The red plastic caps are marked "ORPLS 1106 WAPLS 17372". Set steel fence post 9' West of corner monument with "witness" sign nailed to it. Rebar accessories have "bearing object" signs wired to them.



LOCATION AND COMMENTS: Corner falls in the center of a North-South farm road.

FIRM: Wells Surveying
P.O. Box 1696
Pendleton, OR 97801

COMPASS DECLINATION: 18° East

Surveyor's Seal

\2N28J5

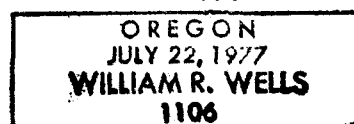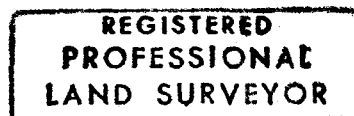

17-065-C