

OREGON CORNER RESTORATION FORM

Section 34 Township 3N
County Umatilla Date: 03/08/10

Range 29E

Corner Designation: 3N29Z15

1/4 Corner common to sections 34 T3NR29E, 3 T2NR29E.

_____	Condition Report Only
_____X_____	Not Found
_____X_____	Remonumented
_____	Unrecorded
_____X_____	Surveyed In
_____X_____	Referenced Out


Previous Renewals / Surveys, etc.

Originally Surveyed by David P. Thompson. He set a post in a mound of earth in 1859.
Harris set 1 1/4" Pipe in Survey Q-76-B.


Monuments and Accessories Found: (Condition and Source)

Found 1 1/4" Pipe at Harris's called location.

Diagram

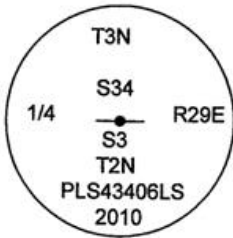

Sketch

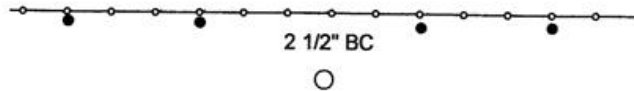

NAD 83/91
OREGON STATE PLANE NORTH
INTERNATIONAL FEET

N740399.66
E8541050.54

LAT - 45° 41' 23.53846" N
LON - 119° 10' 24.79254" W

Monument (s) Set (Procedures and Description)

Set a 1 1/4" X 30" galvanized iron pipe with a 2 1/2" brass cap, flush with ground, buried Harris's 1 1/4" X 24" pipe alongside. Cap marked as shown above.

References Set:

- A 5/8"x30" Iron rebar w/ypc #43406 lies N 65°20' W, 43.88'.
- A 5/8"x30" Iron rebar w/ypc #43406 lies N 31° W, 21.55'.
- A 5/8"x30" Iron rebar w/ypc #43406 lies N 42°45' E, 26.16'.
- A 5/8"x30" Iron rebar w/ypc #43406 lies N 68° E, 52.88'.

Location and Comments

The corner is 2.0 miles East of the cattle guard at the South end of Snow Road along the East-West fence.

Compass Declination
17° E

Surveyors Seal

REGISTERED
PROFESSIONAL
LAND SURVEYOR

Robert D. English
OREGON
JANUARY 11, 2005
ROBERT DOUGLAS ENGLISH
43406LS

RECEIVED BY:

Date: 1-11
Rec'd By: KK
No. 11-21-R

Firm / Agency

Survey One, LLC.
P.O. Box 382
Pendleton, OR 97801
(541) 276-2055

RENEWAL DATE: 12/31/11