

OREGON CORNER RESTORATION FORM

Section 36 Township 3N
County Umatilla Date: 05/24/10

Range 29E

Corner Designation: 3N29Z23

1/4 Corner common to section 36 T3NR29E, 1 T2NR29E.

_____	Condition Report Only
_____X_____	Not Found
_____X_____	Re monumented
_____	Unrecorded
_____X_____	Surveyed In
_____X_____	Referenced Out


Previous Renewals / Surveys, etc.

Originally Surveyed by Gates in 1859. He set a post in a mound of earth.


Monuments and Accessories Found: (Condition and Source)

None.

Diagram

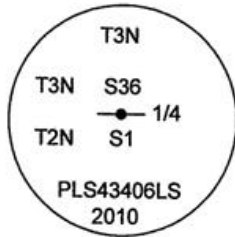

Sketch

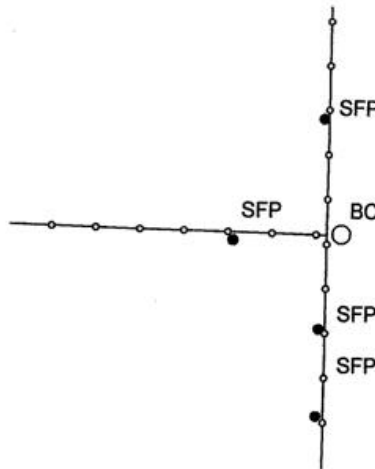

NAD 83/91
OREGON STATE PLANE NORTH
INTERNATIONAL FEET

N740656.60
E8551636.29

LAT - 45° 41' 24.33221" N
LON - 119° 07' 55.62515" W

Monument (s) Set (Procedures and Description)

Set a 1 1/2" x 30" galvanized iron pipe with a 2 1/2" brass cap monument, flush with ground, stamped as shown above. I held the old existing fence intersection as best evidence.

References Set:

- A 5/8" x 30" Iron rebar w/rpc #43406 lies S 01°40' W, 23.51'
- A 5/8" x 30" Iron rebar w/rpc #43406 lies S 01° W, 39.34'
- A 5/8" x 30" Iron rebar w/rpc #43406 lies N 86° W, 21.21'
- A 5/8" x 30" Iron rebar w/rpc #43406 lies N 02°20' W, 19.12'

Location and Comments

The only way to get to this corner is through Cunningham Sheep Co.'s Nolan Ranch access roads from the South.

Compass Declination
17° E

Surveyors Seal

REGISTERED
PROFESSIONAL
LAND SURVEYOR

Robert D. English
 OREGON
 JANUARY 11, 2005
 ROBERT DOUGLAS ENGLISH
 43406LS

RENEWAL DATE: 12/31/11

RECEIVED BY:

Date: 1-11
 Rec'd By: KK
 No. 11-31-R

Firm / Agency

Survey One, LLC.
 P.O. Box 382
 Pendleton, OR 97801
 (541) 276-2055