

PUBLIC LAND CORNER CONDITION REPORT

UMATILLA COUNTY, DATE: 01/25/02

CORNER DESIGNATION: 2N32E1, The Northeast Corner of Section 12.


PREVIOUS RENEWALS/ SURVEYS, ETC.:

Most recent Umatilla County Surveyors Corner Record: 88-19-C.

MONUMENT AND ACCESSORIES FOUND:

Found a 2 1/2" brass cap on galvanized iron pipe monument with top 3" above ground level at North top of break of field road in small mound of stones, marked as shown in monument marking detail. Found monument is a witness corner N 0° 13'07" E., 19.00 feet from true corner point. The corner accessories per corner record are intact except signs are missing. Corner has 2 accessories.

MONUMENT MARKING DETAIL:

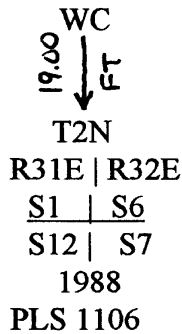

LOCATION & COMMENTS:

Corner located on John Brogoitti land. Can also be accessed from Interstate 84, by crossing South right-of-way fence.

STATE PLANE COORDINATE, OREGON NORTH ZONE, NAD83/91, INT. FOOT:

True corner point:

N = 736207.73

E = 8618375.84

Witness corner position:

N = 736226.73

E = 8618375.51

FIRM/AGENCY: William R. Wells
P.O. Box 1696
Pendleton, Oregon 97801

2N32E1

REGISTERED
PROFESSIONAL
LAND SURVEYOR

RECEIVED BY

Umatilla County Sur

W. R. Wells

Date 2-02

OREGON
JULY 22, 1977
WILLIAM R. WELLS
1106

Rec'd by KK

No. 02-43-9

Renews 6-30-02

05

26

05

*Found
Q.
Stations*