

**OREGON CORNER RESTORATION FORM**

Section 11 Township 2N Range 32E  
 County Umatilla Date: August 26, 2011

Corner Designation: 2N32G21

Condition Report Only  
 Not found  
 Remonumented  
 Unrecorded  
 Surveyed in  
 Referenced out


Quarter corner to sections 11 and 12, T2N, R32E, W.M.  
 Umatilla County, Oregon.

Previous Renewals / Surveys, etc.


This corner was originally established in 1864 by U.S. Deputy Surveyor Daniel Chaplin. His work was superceded in 1871 by U.S. Deputy Surveyor Zenas F. Moody. The work by Moody was superceded by James Currin and James Noland under special instructions dated May 4, 1887. Their record reads: Stone 9x8x7 in. with pits N & S 5 1/2' dist. In 1968, under survey E-29-B Wayne Harris set a brass cap at a position determined from the superceded data by Moody.

Monument and Accessories found: ( condition and source )

None. The point falls in a mound covered in trash at the intersection of field lines. The cap by Harris bears S67°23'W, 14.6' more or less.

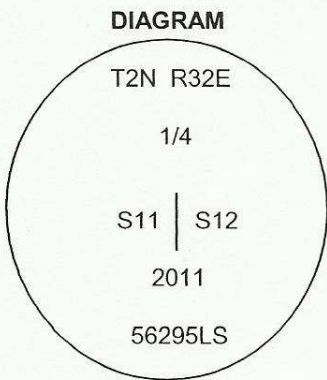

☒ = Set Brass Cap  
 ● = Set iron rebar reference

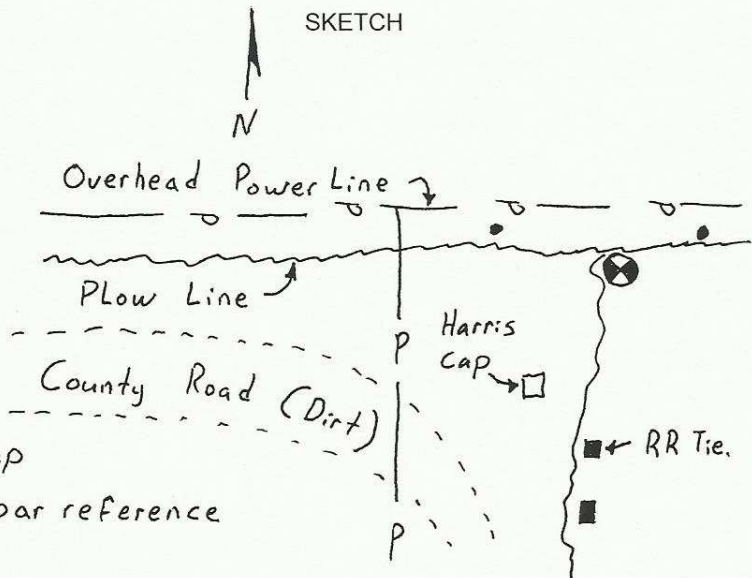

**MONUMENT (S) AND ACCESSORIES SET (Procedures and Description)**

I set a 2 1/4" brass cap on a 1 1/2" x 30" galvanized steel pipe at the proportionate point using the fractional section data from Currin and Noland. This point falls at the intersection of field lines running East, West, and South.

For references I set two 5/8" x 24" iron rebars with 1 1/8" orange plastic caps stamped WTS and 56295LS as described below:

- an iron rebar bears N73°57'15"E, 23.04 feet;
- an iron rebar bears N65°42'13"W, 16.45 feet;

The monument was set and references were tied using a Trimble R7/R8 RTK GPS

Location and comments

Compass Declination

Surveyors Seal

RECEIVED BY:

Umatilla County Surveyor  
 Date: 8/29/2011  
 Rec'd By: Jay Kobak  
 No. 11-092-13

Firm / Agency  
 Witness Tree Surveying  
 Address  
 P.O. Box G  
 Pilot Rock, Or. 97868  
 Party Chief  
 Stephen K, Haddock

REGISTERED  
 PROFESSIONAL  
 LAND SURVEYOR

*Stephen K. Haddock*

OREGON  
 JULY 9, 2001  
 STEPHEN K. HADDOCK  
 56295LS

RENEWAL DATE 6-30-13