

CERTIFIED RECORD OF LAND CORNER MONUMENTATION

History of original corner establishment:

Reservation Boundary # 5.

Cross Mark on Rock



SW 1/4 Sec 10, T2N, R32E


Description of corner evidence found:

Cross Mark on Rock

Description of monument and accessories I established to perpetuate the original location of this corner

Flag Pole in front of Pendleton Community Hosp.

80' Relay Antenna on horizon above Pendlet High School. Base of pole.

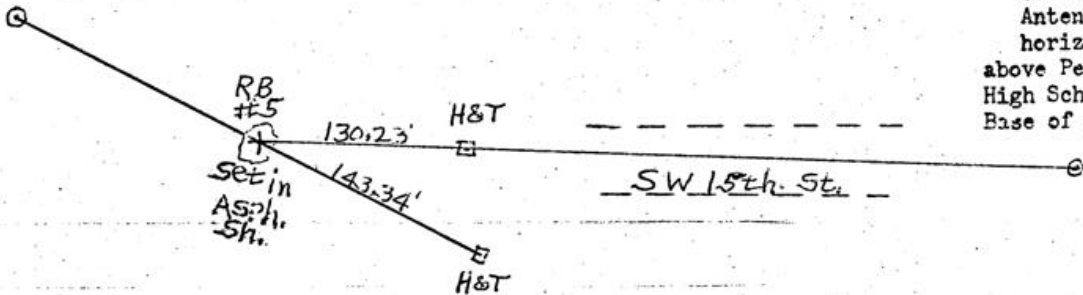

Office of COUNTY SURVEYOR County of UMATILLA
State of OREGON, I hereby certify that the within instrument was filed in this office for record on the 5 day of FEBRUARY 1970, at o'clock m., (signed) Ralph Thompson by (DEPUTY)